


KANSAS Barton

FORM 51 5M PETROL

Section 20 Township 16 Range 11W

Well No. 5 Prusa (K65 PRL)

Company Sinclair Prairie

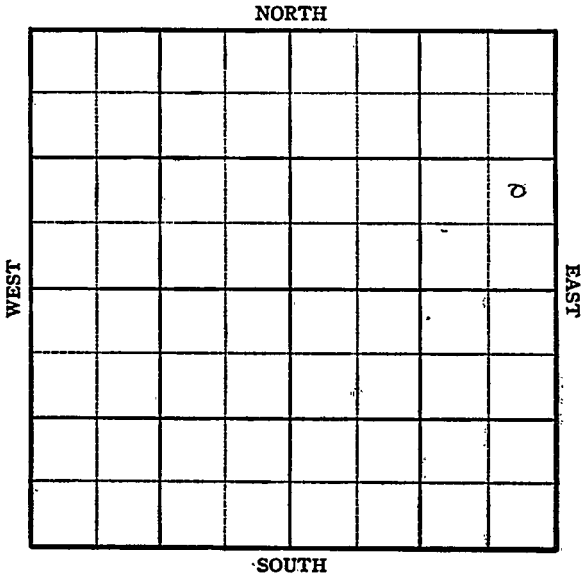

Sec. 20 Twp. 16 R. 11W

Well No. #2 Prusa (K65 DRL) Farm

Sinclair Prairie Company


Susank

_____ Ft. from N. Line

990 _____ Ft. from S. Line

330 _____ Ft. from E. Line

_____ Ft. from W. Line

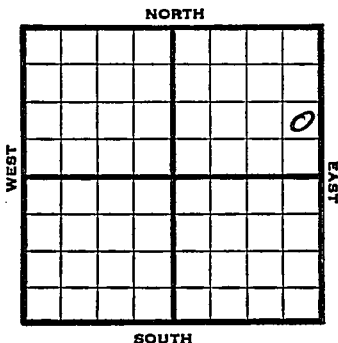

NE SE NE

1945 Elev. 1880 REPORT

10/31 Derrick

11/7 10" @ 322
Drlg. 1055

11/14 Drlg. 2760'

11/21 Lans 3025
Arb. 3357
TD 3367' S.D.

11/28 TD 3370
5" @ 3359 water
Plug 3271
20 shots 3203-3210 5 gals. Wtr. per hr.
1000 acid.

12/5 Cong 3303
Arb. 3357
5" @ 3359
Lans 3025
Plug 3195
23 shots 3168-3176
1000 acid.
TD 3370
Pump 43 oil plus 160 Wtr. Pot.
Grav. 39.0

COMPLETED

KANSAS Kansas Pool Name Susank

Map No. 4-55 Sec. 20 Twp. 16 R. 11W

Well No. 15 Prusa (KLS DRL)

Sinclair-Prairie Company

COMPLETED

Contractor

NE SE NE

E.I. 1980

SECTION PLAT

_____ Ft. from N. Line

990 Ft. from S. Line

330 Ft. from E. Line

_____ Ft. from W. Line

			0

Barton County

Location _____

Rig up _____

Drilling and Remarks:

Coring 3308
28" 3357
5" 3358
Lens 3025
Plug 3195
282 to 3165 - 76
1000 acid

RECORD

Cased _____ in., _____ ft.

Sand _____

Gas _____

Oil _____

Total Depth 3370

PRODUCTION

1st 24 hrs. Nat. _____

1st 24 hrs. after shot _____

Gas _____ Cu. Ft.

Dry Hole _____

Abandoned _____

Date 39th Dec

DEC 5 1945

19

S. J. LEWIS

Scout