Barton


Form 51—5M—11-38—Palace

KANSAS

Section 20 Township 16 Range 11-W

Well No. 1 Joe Prusa

Company Sinclair Prairie

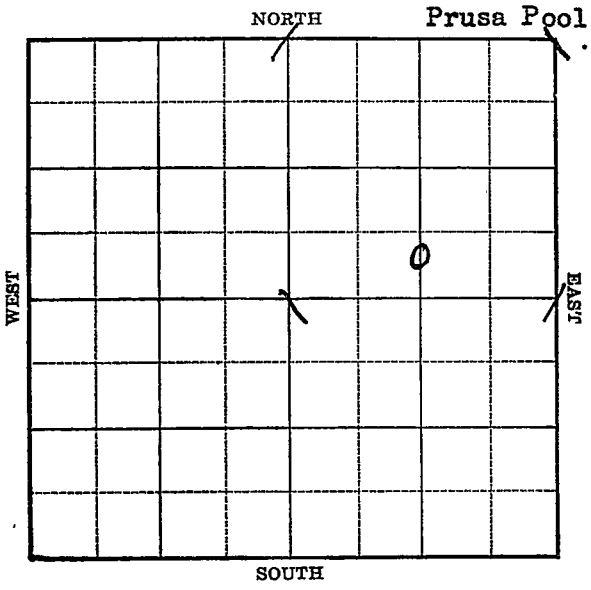

FORM 252-A 5M 10-38 **KANSAS** Barton

Sec. 20 Twp. 16 R. 11-W

Well No. #1 Joe Prusa Farm

Sinclair-Prairie Company


(Prusa)

____ Ft. from N. Line

440 Ft. from S. Line

1300 Ft. from E. Line

____ Ft. from W. Line

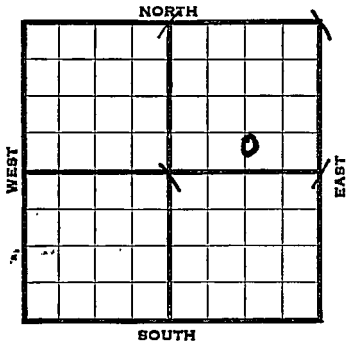

Elev. 1871

1938	REPORT
12/28	B.R.R.
1939	
1/6	13" - 145'. Drlg. 1160'.
1/13	Drlg. 2790'.
1/20	Lans. 3015'. Arb. 3289'.
	T. D. 3296' S. S. 0.
	7" - 3289'. RUST.
1/27	Drilled plug. 2500' oil 5 hrs.
	T. D. 3305'. Total fill-up
	3000'. Swab 400 oil in 5 hrs.
2/1	7" - 3289'.
	Arb. 3289'.
	T. D. 3305'.
	Pump 413 bbls. 8 hrs.
	Potential 1252 bbls. Nat'l.
	COMPLETED

Form 26—1M Bks.—2-29 Barton KANSAS

Map No. 55 Sec. 20 Twp. 16 R. 11W

Well No. 1 Joe Prusa

Sinclair Prairie Company

Contractor

FIRST REPORT

C S L NE

Ft. from N. Line


440 Ft. from S. Line

1300 Ft. from E. Line

Ft. from W. Line

PRUSA POOL

SECTION PLAT

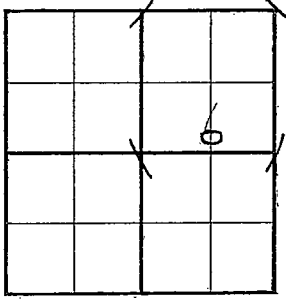

Location

Rig up

Drilling and Remarks:

BRR

RECORD

Cased in., ft.

Sand

Gas

Oil

Total Depth

PRODUCTION

1st 24 hrs. Nat.

1st 24 hrs. after shot

Gas Cu. Ft.

Dry Hole

Abandoned

Date

DEC 28 1938 19

H. D. Hatfield Scout

Form 26—1M Bks.—2-29

Barton KANSAS

Map No. Sec. 20 Twp. 16 R. 11W

Well No. 1 Joe Prusa

Sinclair Prairie Company

Contractor

COMPLETED

C S L NE

Ft. from N. Line


440 Ft. from S. Line

1300 Ft. from E. Line

Ft. from W. Line

PRUSA POOL

SECTION PLAT

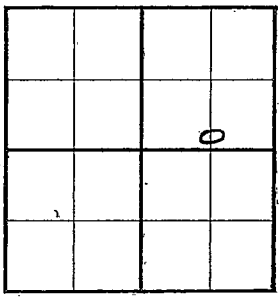

Location

Rig up

Drilling and Remarks:

P-41 3/8

Pot 1752 NAT.

RECORD

Cased 7 in., 3289 ft.

Sand Arb 3289

Gas

Oil

Total Depth 3305

PRODUCTION

1st 24 hrs. Nat.

1st 24 hrs. after shot

Gas Cu. Ft.

Dry Hole

Abandoned

Date

FEB 1 - 1939 19

H. D. Hatfield Scout