


Map No. Kanawha Sec. 9 Twp. 33 R. 2^e

Well No. 1 Wright Farm

Marland O & R Company

NORTH

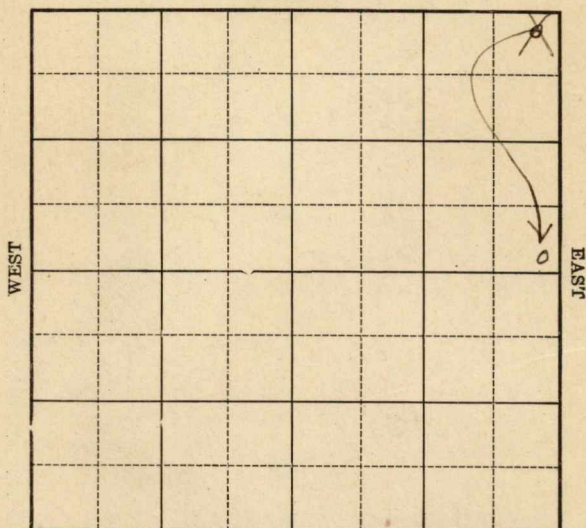

SOUTH

Location _____

Drilling Remarks

Rig Up

Drilling Remarks

RECORD

Cased_____in. _____ft.

Sand

Gas _____

Oil _____

Total Depth -----

PRODUCTION

1st 24 hrs. Nat. _____

1st 24 hrs. after shot -----

Gas_____cu. ft.


Dry Hole.....

Abandoned -----

Map No. Kansas Sec. 9 Twp. 33 R. 2E
 Well No. 1 Wright Farm
Marland Oil Co. Company

330 Ft. from N. Line330 Ft. from S. Line330 Ft. from E. Line

_____ Ft. from W. Line

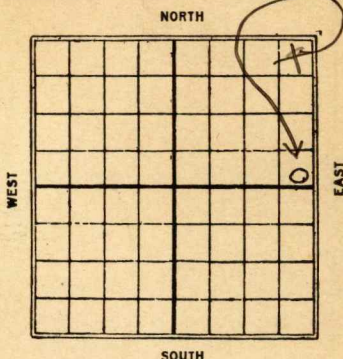

Offsch
 Ticket returned

Date

REPORT

1925	
10/6	Location
10/13	_____
10/21	_____
10/28	_____
11/4	_____
11/18	same timbers on Location
1926	
4/13	_____
4/21	Skidding 20 ft north
4/29	Spud
5/5	Csg trouble I.D. 370'
5/12	Dlg 275'
5/19	Log 15 1/2" C 405'
5/26	No report
6/2	II Dlg 1495'
6/9	" 1675'
6/16	" 1925'
6/23	T.D. 1925 U.R.
6/30	Dlg 2045'
7/14	" 2465'
7/22	" 2760'

8/11 - Dlg 3180

8/18 - top chat 3160, line
3197, forget 3220 - T.D.

8/25 - S.D. 3280

9/1 - J.D. 3280 ~~0~~ S.D.
to get some titles

9/8 - J.D. 3280 - S.D.

9/15 - getting ready to start

9/16 - Top chat 3160 Bottom
line 3340 Dlg 3355 in
slate (2el)

9/20 - ~~3~~ 3412-3453 1200 fh
water in hole
Dlg in line 3460

9/22 - T.D. 3461 Running 5"
H.F.W. (2el)

9/29 - Try to shut off water

10/6 - 3475 - H.F.W. S.D.
high water

10/13 - Top Wilcox 3412
J.D. 3528 - D & A

Map No. **KANSAS** Sec. 9 Twp. 33 R. 2E

Well No. 1 Straight

Marland O & R Company

Contractor

SECTION PLAT

330 Ft. from N. Line

_____ Ft. from S. Line

330 Ft. from E. Line

_____ Ft. from W. Line

			0

FIRST REPORT

Location _____

Rig up _____

Drilling and Remarks:

Location

RECORD

Cased _____ in., _____ ft.

Sand _____

Gas _____

Oil _____

Total Depth _____

PRODUCTION

1st 24 hrs. Nat. _____

1st 24 hrs. after shot _____

Gas _____ Cu. Ft.

Dry Hole _____

Abandoned _____

Date

OCT 6 1925

S. J. LEWIS

Scout

K1 KANSAS

Map No. _____ Sec. 9 Twp. 33 R. 2EWell No. 1 WrightMarland Oil Company_____
Contractor

SECTION PLAT

Ft. from N. Line330 Ft. from S. Line330 Ft. from E. Line_____
Ft. from W. Line

			0

Correction

Location _____

Rig up ✓

Drilling and Remarks:

I reported this
in NE NE
should be
SE NE
an off set to
us.

RECORD

Cased _____ in., _____ ft.

Sand _____

Gas _____

Oil _____

Total Depth _____

PRODUCTION

1st 24 hrs. Nat. _____

1st 24 hrs. after shot _____

Gas _____ Cu. Ft.

Dry Hole _____

Abandoned _____

Date

MAR 17 1926

S. J. LEWIS

Scout

Map No. *1* **KANSAS** Sec. *9* Twp. *33* R. *2E*Well No. *1 Knight**Marland Oil* Company

Contractor

SECTION PLAT

Ft. from N. Line

330 Ft. from S. Line*330* Ft. from E. Line

Ft. from W. Line

			0

ABANDONED

Location

Rig up

Drilling and Remarks:

*Top Oil Co. 3412.**7113528**D & A.*

RECORD

Cased _____ in., _____ ft.

Sand _____

Gas _____

Oil _____

Total Depth _____

PRODUCTION

1st 24 hrs. Nat. _____

1st 24 hrs. after shot _____

Gas _____ Cu. Ft.

Dry Hole _____

Abandoned _____

Date

OCT. 13 1926

S. J. LEWIS

192

Scout

MAP NO. K1 KANSAS SEC. 9 TWP. 33S R. 2E
 WELL NO. 1 Wright
Murphy COMPANY

CONTRACTOR

SECTION PLAT

_____ FT. FROM N. LINE

_____ FT. FROM S. LINE

_____ FT. FROM E. LINE

_____ FT. FROM W. LINE

RECORD

LOCATION _____

CASED _____ IN. _____ FT.

RIG UP _____

SAND _____

DRILLING AND REMARKS:

GAS _____

OIL _____

TOTAL DEPTH 3528

PRODUCTION

1ST 24 HRS. NAT. _____

1ST 24 HRS. AFTER SHOT _____

GAS _____ CU. FT.

DRY HOLE ☒ABANDONED ☒

DATE

10/41926

SCOUT