


Section 16 Township 25 Range 5E

Well No. #56 L. W. Robinson

Company Deep Rock

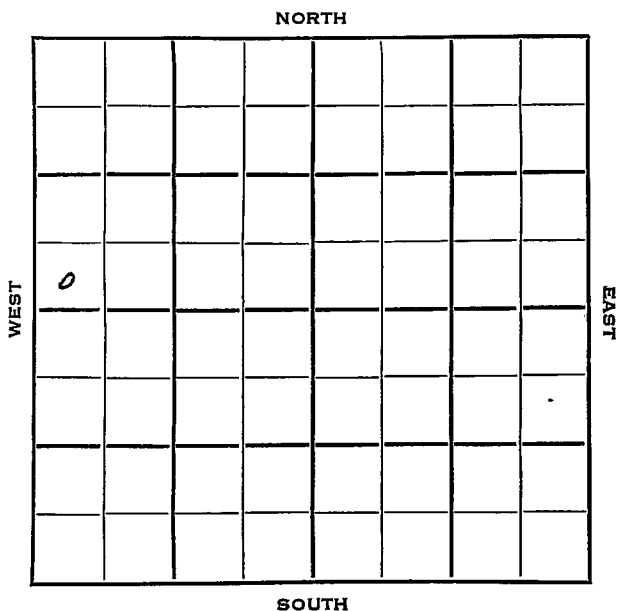

Butler

16

25

5E

Sec. _____ Twp. _____ R. _____

Well No. #56 L. W. Robinson Farm _____

Deep Rock Company _____

Rex & Morris - Contr. Contractor _____


_____ Ft. from N. Line

330 Ft. from S. Line

_____ Ft. from E. Line

330 Ft. from W. Line

SW SW NW

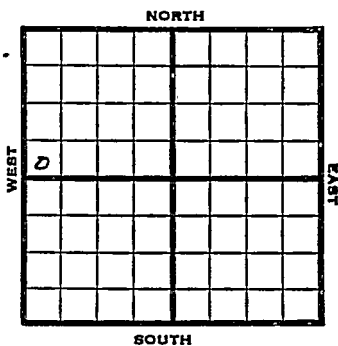

1953 Elev. 1358' REPORT

3/11 Location

4/22 Spud 3-13-53
 Oil Well
 TD 2475
 8" @ 127
 KC 1995, B KC 2142, Viola 2472,
 TD 2475
 5" @ 2473
 CO to 2475
 S/3 boph 500A
 S/73 bopd
 Comp. 125 bopd

COMPLETED

County Butler State Kansas

Sec. 16 (Blk. 25) (Sur. 5E) (Twp.) (Rge.) Map No.

Operator Deep Rock

Well No. 56 Farm L. W. Robinson

Elev. 1358 Location SW SW NW

330 Ft. From S Line NW

330 Ft. From W Line Quarter

1st. Report

Completion APR 22 1953

Remarks

Rex & Morris - Contr.

Spudding Date 3-13-53

Drlg. Data Oil well TD 2475

8" @ 127 KC 1995 B KC 2142

Viola 2472 TD 2475 5" @ 2473

CO to 2475 S/ 3 boph 500 A

S/ 73 bopd Comp. 125 bopd

J. G. McGEHEE