

KANSAS

Sumner

FORM 51 5M PETROL

Section 10 Township 33 Range 2-E

Well No. #1 Tottan

Company E. S. Adkins

NORTH

13

0							

SOUTH

WEST

EAST

KANSAS

Sumner County

Sec. 10 Twp. 33 R. 2E

Well No. #1 Tottan Farm

E. S. Adkins Company

Miscellaneous


 Ft. from N. Line

330 Ft. from S. Line

 Ft. from E. Line

330 Ft. from W. Line

SW/c

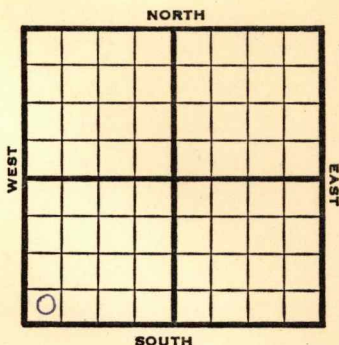

1946

Elev. 1118

R E P O R T

2/20

10" @ 125'
Drlg. 2300'

2/28

Drlg. 3304'


3/6

Arb. 3471
TD 3495'

ABANDONED

KANSASKansas Pool Name MiscellaneousMap No. Sec. 10 Twp. 33 R. 2EWell No. 1 TottanE. S. Adkins Company**FIRST REPORT**Contractor

SW/c

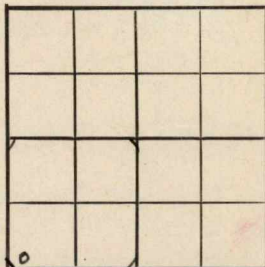SECTION PLAT Ft. from N. Line330 Ft. from S. Line Ft. from E. Line330 Ft. from W. LineSumner CountyLocation Rig up

Drilling and Remarks:

10"-1252300**RECORD**Cased in., ft.Sand Gas Oil Total Depth **PRODUCTION**1st 24 hrs. Nat. 1st 24 hrs. after shot Gas Cu. Ft.Dry Hole Abandoned

Date

FEB 20 194619S. J. LEWISScout

KANSASKansas Pool Name MiscellaneousMap No. 1 Sec. 10 Twp. 33 R. 2EWell No. 1 TottenE. S. Adkins Company**ABANDONED**

Contractor

SW/c

E.I. 118
SECTION PLAT

 Ft. from N. Line330 Ft. from S. Line Ft. from E. Line330 Ft. from W. LineSumner CountyLocation Rig up

Drilling and Remarks:

See 43471**RECORD**Cased in., ft.Sand Gas Oil Total Depth 3495**PRODUCTION**1st 24 hrs. Nat. 1st 24 hrs. after shot Gas Cu. Ft.Dry Hole Abandoned

Date

MAR 6 194619S. J. LEWISScout