


Map No. **KANSAS** Sec. 16 Twp. 35 R. 4E

Well No. 1- Budden Farm
Stocum et al Company

_____ Ft. from N. Line
660 Ft. from S. Line
_____ Ft. from E. Line
660 Ft. from W. Line
1931

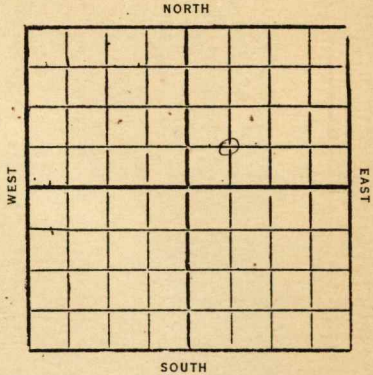

Date	REPORT
12/22	Regr up
12/30	Spag 130'
1/32	
1/76	Drlg 475'
1/13	—
1/20	S.D 475'
1/27	—
2/3	Stg 10"-560'
2/10	Drlg 600'
2/17	No report
2/26	S.D 600'
3/2	Drlg 1450'
3/9	S.D 1610'
3/16	Drlg 1630'
3/22	6"-1663 Drlg 1715'
3/30	S.D 1790'
4/6	—
4/13	—
4/20	—
4/27	TD 1790' Fsg bailer (over)

5/4- 5"-1790
July 1884

5/11- SD 1920

5/18 —

5/25 —

6/1 —

6/8 —

6/15 —

6/22 —

6/29 —

7/6 —

7/13 —

7/20- TD 1920

Abandon

Cowley

Map No. **KANSAS** Sec. *16* Twp. *35* R. *4*^E

Well No. *1* *Judson*

Blocum et al Company

Contractor

FIRST REPORTS

SECTION PLAT

..... Ft. from N. Line

660 Ft. from S. Line

..... Ft. from E. Line

660 Ft. from W. Line

		0	

Location.....

Rig up.....

Drilling and Remarks:

Rigging up

RECORD

Cased..... in., ft.

Sand.....

Gas.....

Oil.....

Total Depth.....

PRODUCTION

1st 24 hrs. Nat.....

1st 24 hrs. after shot.....

Gas..... Cu. Ft.

Dry Hole.....

Abandoned.....

Date

DEC 22 1931

CHAS. L. SHERWOOD

192.....

Scout

Cowley

KANSAS

Map No. Sec. *16* Twp. *35* R. *4*

Well No. *1* *Purser*

Stocum et al Company

Contractor

COMPLETED

SECTION PLAT

..... Ft. from N. Line

660 Ft. from S. Line

..... Ft. from E. Line

660 Ft. from W. Line

		o	

ABANDONED

Location

Rig up

Drilling and Remarks:

RECORD

Cased in., ft.

Sand

Gas

Oil

Total Depth *1920*

PRODUCTION

1st 24 hrs. Nat.

1st 24 hrs. after shot

Gas Cu. Ft.

Dry Hole

Abandoned

Date

JUL 20 1932

CHAS. L. SHERWOOD

192

Scout