


Section 8 Township 25 Range 5-E

Well No. 205 Wilson

Company Cities Service Oil

Eldorado pool

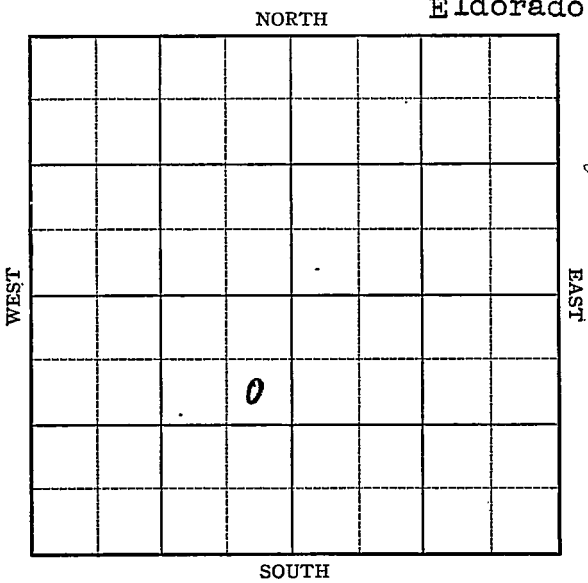

Sec. 8 Twp. 25 R. 5-E

Well No. #205 Wilson Farm

Cities Service Oil Company


(Eldorado)

990 Ft. from N. Line

_____ Ft. from S. Line

330 Ft. from E. Line

_____ Ft. from W. Line

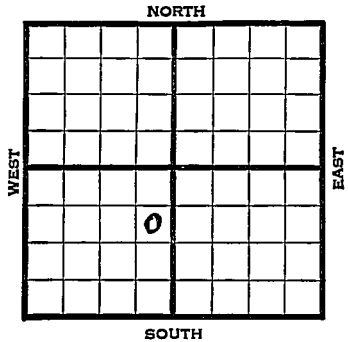

1941	REPORT
10/1	Lans. 1663' S.S.O. 1683-1737'
	K.C. 1939' 5" - 1946'
	2000 acid. Testing.
10/9	" " "
10/15	K.C. 1939'
	5" - 1946'
	T.D. 2010'
	2000 acid.
	Pump 201 oil & 10 water.
	36. Gravity
	COMPLETED

45- Map No. K-14 Sec. 8 Twp. 25 R. 5E

Well No. 205 Wilson

Cities Service Oil Company

Contractor

COMPLETED

SECTION PLAT


SE NE SW

990 Ft. from N. Line

_____ Ft. from S. Line

330 Ft. from E. Line

_____ Ft. from W. Line

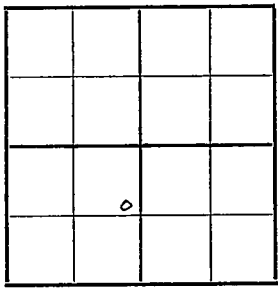

Eldorado Pool

RECORD

Location _____

Cased _____ in., _____ ft.

Rig up _____

Sand _____

Drilling and Remarks:

Gas _____

Oil _____

KC 1939

Total Depth 2010

5" 1946

2000 acid

Pump 201 oil 10 water

PRODUCTION

1st 24 hrs. Nat. _____

1st 24 hrs. after shot _____

Gas _____ Cu. Ft.

Dry Hole _____

Abandoned _____

36° Gr.

Date

OCT 15 1941