


SECTION 8 TOWNSHIP 21 S RANGE 3 E

WELL NO. # 2 Unger

COMPANY C. L. Carlock

C W/2 NE NE NORTH

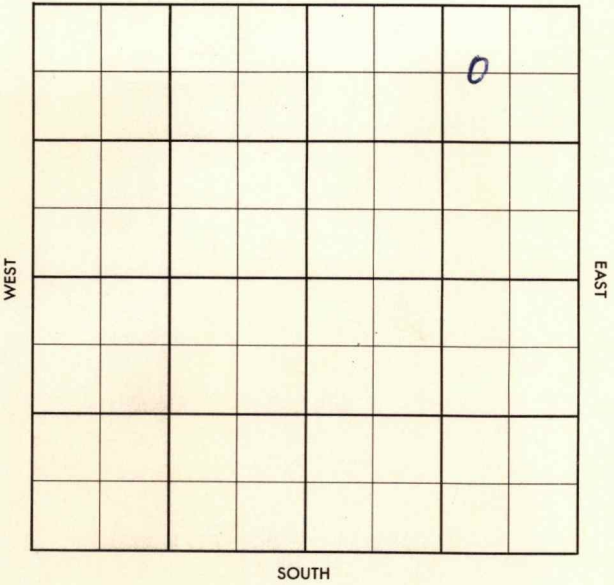

County Marion Elev. _____
 Sec. 8 Twp. 21 Rgs. 3E
 Company C. L. Carlock
 Farm Name Unger No. 2

TOPS	DEPTH	LOG	DATUM	Loc. in Sec.
Anb.				C W/2 NE NE
Tr.				
H.				
Tr.				
Dg.				
Bl.				
L.				Geol. _____
K.C.				Contr. _____
B.K.C.				
Ce.				
C.	<u>2524</u>			Bedell & Cat
M.	<u>2543</u>			
M.				Pool
K.	<u>2775</u>			Unger
Mz. <u>Hunt</u>	<u>2819</u>			
Mq.	<u>2825</u>			
V.				
S.				
S.				
A.				
R.				
Pe.				
G.				
T.D.	<u>2830</u>			



Date Comm. M I R T AUG 28 '57 8-22-57 25/8
115
DCA

County Marion Elev. _____
 Sec. 8 Twp. 21 Rge. 3E
 Company C. L. Carlock
 Farm Name Unger No. 2

Co.

TOPS	DEPTH	LOG	DATUM
Anh.			
TP.			
H.			
Tr.			
Dg.			
BL.			
L.			
K.C.			
B.K.C.			
Ce.			
C.			
M.			
M.			
K.			
Mz.			
Me.			
V.			
S.			
S.			
A.			
R.			
PE.			
G.			
T.D.			

Loc. in Sec. C W/2 NE NE

Geol. _____
 Contr. Bedell & Catt

Pool Unger

FIRST REPORT			
AUG 21 1947			

Co.

No.

Sec.

T.

R.

Date Comm. M I R T

