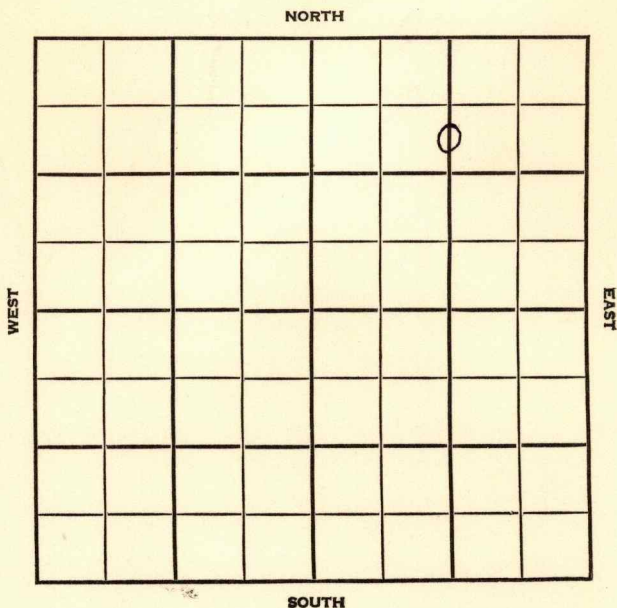


Rice

BANKS

Section 13 Township 20 Range 6 WWell No. #2 ShumwayCompany Braden Drlg.

Rice

KANSAS

SEC.	TWP.	R.
13	20	6W

WELL NO.

#2 Shumway

FARM

COMPANY

Braden Drlg.

CONTRACTOR

Co. Tools


Welch-Bornholdt

_____ Ft. from N. Line

_____ Ft. from S. Line

_____ Ft. from E. Line

_____ Ft. from W. Line

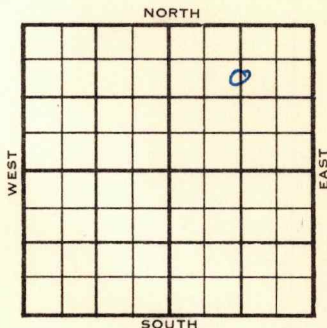C S $\frac{1}{2}$ N $\frac{1}{2}$ NE

	ELEVATION	REPORT
1955	1568'	

8/17 Comm 8/13/55
8" @ 138/125
Drlg 1020

9-7 5 $\frac{1}{2}$ " @ 3305
DD 3339, frac
Comp. 60 bopd
TOPS: M. 3301
T.D. 3317'

COMPLETED

Date Comm.	8 -13-55	SEP 7 1955	Sec.
	8" @ 138/125	5 $\frac{1}{2}$ " @ 3305 DD 3339	
	frac Comp.	60 bopd	

frac Comp. 60 bopd

County Rice Elev. _____
Sec. 13 Twp. 20 Rgs. 6W
Company Braden Drlg.
Farm Name Shumway No. 2

TOPS	DEPTH	LOG	DATUM
Anh.			
Tp.			
H.			
Tr.			
Dg.			
BL.			
L.			
K.C.			
B.K.C.			
Ce.			
C.			
M.			
M.			
K.			
Mz.			
Mq.			
V.			
S.			
S.			
A.			
R.			
PE.			
G.			
T.D.			

Loc. in Sec. _____
C S $\frac{1}{2}$ N $\frac{1}{2}$ NE
Geol. _____
Contr. _____
Co. tools
Pool _____
Welch-Bornholdt

AUG 17 '55
FIRST REPORT

Date Comm. 8-13-55
8" @ 138/125 drlg. 1020
12