KANSAS


FORM 51 5M 1-42 PETROL O.W.W.O.

Barton

Section 20 Township 16 Range 11-W

Well No. #4 Peter Schmidt

Company Sinclair ~~Prairie~~ O/C & GAS

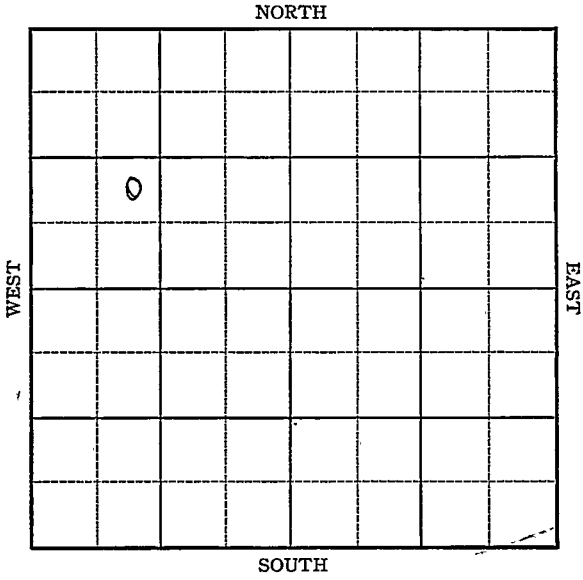

FORM 252-A
5M 9-42 GASS

KANSAS U.W.W.O. U.W.W.O. Barton

Sec. 20 Twp. 16 R. 11-W

Well No. #4 Peter Schmidt Farm

Sinclair ~~Prairie~~ Oil & Gas Company

Kraft Prusa Pool


_____ Ft. from N. Line

990 Ft. from S. Line

_____ Ft. from E. Line

990 Ft. from W. Line

El. 1887

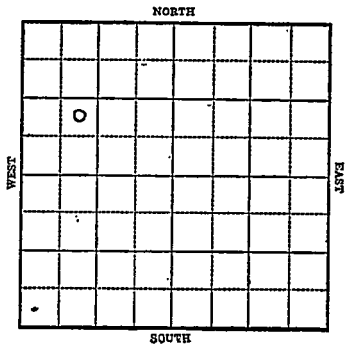

1943	REPORT
2/10	Derrick
2/17	SH
2/24	8" Casing set 296 Drlg. 1625'
3/3	Drlg. 3200'
3/10	Arb 3309½ TD 3312 5" Casing set 3309½ RHST.
3/16	TD 3318½-2700' oil 5 hrs 2000 acid pump 403oil in 22 hrs
3/24	3000 acid estimate Pot 700'
3/31	" " "
4/7	" "
4/14	" " "
4/21	" " "
4/28	- Arb. 3309½ 5" @ 3309½' T.D. 3318½' 5000 gal. acid Depth Pot 956 Gravity 43.6 COMPLETED

OVER

1954

U.W.W.O.

3/24 Arb 3309',
5" @ 3309'
OTD 3318'
PB 3012'
41. 2977'-88' Hydro. P/ 10 bo 17 bw 24 hr.

3/31 Oil Well
TD 3318'
Arb 3309'
5" @ 3309'
OTD 3318'
PB 3012'
41/ 2977-88 Hydro. P/ 10 bo
17 bw 24 hr.
Comp 7 bopd 80% Wtr.

COMPLETED

Form 26 200 Bks 5-42 Petrol

KANSAS

Barton

Map No. 35 Sec. 20 Twp. 16 R. 11W


Well No. 4 Peter Schmidt

Sinclair Prairie Company

FIRST REPORT Contractor

NE SW NW

SECTION PLAT

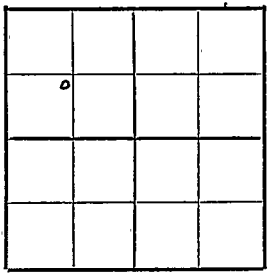

____ Ft. from N. Line

990 Ft. from S. Line

____ Ft. from E. Line

990 Ft. from W. Line

KRAFT PRUSA POOL

Location

Rig up

Drilling and Remarks:

Derrick

RECORD

Cased ____ in., ____ ft.

Sand

Gas

Oil

Total Depth

PRODUCTION

1st 24 hrs. Nat.

1st 24 hrs. after shot

Gas ____ Cu. Ft.

Dry Hole

Abandoned

Date

FEB 10 1943 19

S. J. LEWIS Scout

Form 26 200 Bks 5-42 Petrol

Barton

KANSAS

Map No. Sec. 20 Twp. 16 R. 11W


Well No. 4 Peter Schmidt

Sinclair Prairie Company

COMPLETED Contractor

NE SW NW

SECTION PLAT

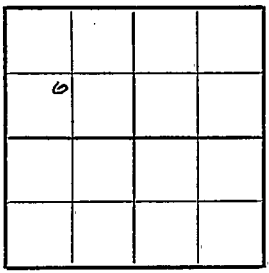

Ft. from N. Line

990 Ft. from S. Line

Ft. from E. Line

990 Ft. from W. Line

KRAFT PRUSA POOL

Location

Rig up

Drilling and Remarks:

Cr ~~of~~ 3309½

5" @ 3309½

5000 acid

Depth ~~R~~ 3956

43 ~~5~~ Gr

RECORD

Cased in., ft.

Sand

Gas

Oil

Total Depth 3318½

PRODUCTION

1st 24 hrs: Nat.

1st 24 hrs. after shot

Gas Cu. Ft.

Dry Hole

Abandoned

Date

APR 2 8 1943 19 S. J. LEWIS Scout

FORM 275 FOR SALE BY KANSAS BLUE PRINT CO.

O.W.W.O.


County Barton State Kansas

Sec. 20 (Blk. Twp.) 16 (Sur. Rge.) 11W Map No.

Operator Sinclair Oil & Gas

Well No. 4 Farm Peter Schmidt

Elev. 1887 Location NE SW NW

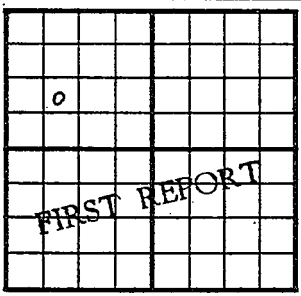

990 Ft. From S Line NW

990 Ft. From W Line Quarter

Ist. Report MAR 2 4 1954

Completion O.W.W.O.

Remarks OWWO

Spudding Date

Drlg. Data Kraft-Prusa Pool

Arb. 3309 5" @ 3309 OTD 3318

PB 3012 41. 2977-88 Hydro. P/ 10 bo

17 bw. 24 hr.

J. G. McGEHEE

FORM 275 FOR SALE BY KANSAS BLUE PRINT CO.

O.W.W.O.


County Barton State Kansas

Sec. 20 (Blk. Twp.) 16 (Sur. Rge.) 11W Map No.

Operator Sinclair Oil & Gas .

Well No. 4 Farm Peter Schmidt

Elev. 1887 Location NE SW NW

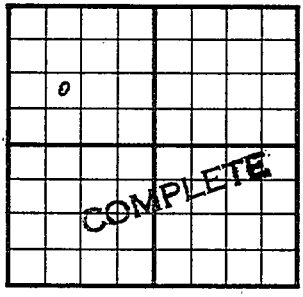

990 Ft. From S Line NW

990 Ft. From W Line Quarter

1st. Report

Completion MAR 31 1954

Remarks (OWWO)

O.W.W.O.

Spudding Date

Drlg. Data Oil well TD 3318

Arb. 3309 5" @ 3309 OTD 3318

PB 3012 41/ 2977-88 Hydro. P/ 10 bo

17 bw 24 hr. Comp. 7 bopd 80% wtr.

J. G. McGEHEE