

O.W.W.O.

KANSAS


Barton County

FORM 51 5M 11-44 PETROL

Section 20 Township 16 Range 11W

Well No. #6 Peter Schmidt

Company Sinclair-Prairie

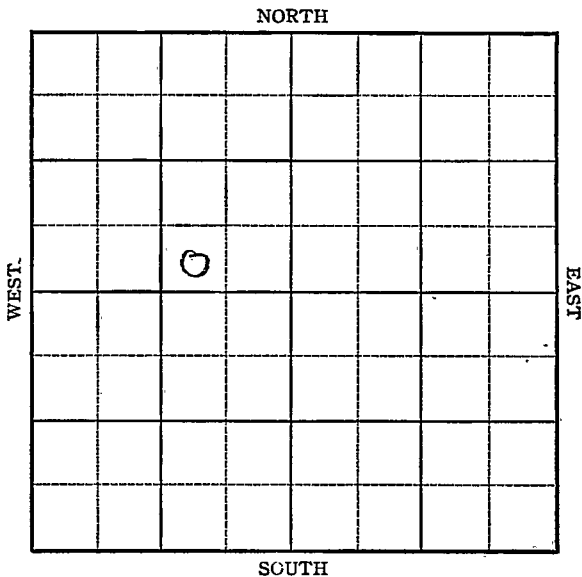

Sec. 20 Twp. 16 R. 11W

Well No. #6 Peter Schmidt Farm


Sinclair Prairie Company

Kraft-Prusa
_____ Ft. from N. Line

330 Ft. from S. Line

990 Ft. from E. Line

_____ Ft. from W. Line

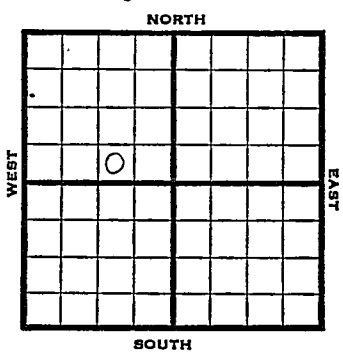

SW SE NW . . .

1946

Elev. 1879' REPORT

2/13

Location

2/21

Surface hole.

2/28

10" - 417' Drlg. 1970'

3/7

Drlg. 3170'

3/14

Lans. 3040' Sdy Cong 3319'
Cherty Cong 3342' Arb. 3381-95' T.D.
5" - 3395' RUST.

3/21

Plug 3351' 16 shots 3324-33'
24 shots 3315-20' Swab 5 oil per hour.
1000 acid. Swab 7 oil per hour 7 hours.

3/28

" " "

4/4

" " " " "

4/10

" " " " "

4/16

" " " " "

4/23

" " " " "

5/1

" " " " "

5/8

Arb. 3379
5" @ 3393
Cong 3319
Perf. Cong. 1000 acid.
TD 3395
Pump 125 Pot.
Grav. 42.0

COMPLETED

OVER

1955
6/15

O.W.W.O.

SP 3027' 48/2971-77 $\frac{1}{2}$ GO
2 $\frac{1}{2}$ GWPH frac. S/48 BO 6% wtr.
24 hr.

Comp. 48 BOPD 6% wtr.

Tops: Dg 2968', L. 3038',

C 3317', A. 3379'

TD 3395'

FIRST REPORT



COMPLETED

KANSAS Pool Name Kraft-Prusa

Map No. 55 Sec. 20 Twp. 16 R. 11W

Well No. 6 Peter Schmidt

Sinclair-Prairie Company

FIRST REPORT

Contractor

SW SE NW

SECTION PLAT

_____ Ft. from N. Line

330 Ft. from S. Line

990 Ft. from E. Line

_____ Ft. from W. Line

	o		

Barton County

Location X

Rig up _____

Drilling and Remarks:

RECORD

Cased _____ in., _____ ft.

Sand _____

Gas _____

Oil _____

Total Depth _____

PRODUCTION

1st 24 hrs. Nat. _____

1st 24 hrs. after shot _____

Gas _____ Cu. Ft.

Dry Hole _____

Abandoned _____

Date

B 1 3 1946 19

S. I. LEWIS Scout

KANSAS Kansas Pool Name Draft-Prusa

Map No. 35 Sec. 20 Twp. 16 R. 11W

Well No. 6 Peter Schmidt

Sinclair-Prairie Company

COMPLETED

Contractor

SW SE SW

E11879
SECTION PLAT

 Ft. from N. Line

330 Ft. from S. Line

990 Ft. from E. Line

 Ft. from W. Line

Barton County

Location

Rig up

Drilling and Remarks:

Cr. 3379
5" @ 3373
Comp. 3319.
Prof Comp.
16000 cu ft
Pump 125 Ps
42 0/32

RECORD

Cased in. ft.
Sand
Gas
Oil
Total Depth 2325

PRODUCTION

1st 24 hrs. Nat.
1st 24 hrs. after shot
Gas Cu. Ft.
Dry Hole
Abandoned

Date

MAY 8 1946 19

S. J. LEWIS Scout

O.W.W.O.

FORM 513 REV. SUNRAY

O.W.W.O.

County Barton

Elev.

Sec. 20

Twp. 16

Rge. 11W

Company Sinclair O & G

Farm Name Peter Schmidt

No. 6

TOPS	DEPTH	LOG	DATUM	Loc. in Sec.
Anh.				SW SE NW
Tr.				
H.				
Tr.				
Dg.	2968			
Bl.				
L.	3038			Geol.
K.C.				Contr.
B.K.C.				
Ce.				
C.	3317			
M.				Pool
M.				
K.				
Mz.				Kraft-Prusa
Ma.				
V.				
S.				
S.				
A	3379			
R.				
Pe.				
G.				
TR.	3395			

FIRST REPORT
 COMPLETE
 JUN 15 '55

Date Comm.

SP 3027 48/ 2971-77 $\frac{1}{2}$ go $2\frac{1}{2}$ gaph

frac S/ 48 bo 6% wtr. 24-hr.

Comp. 48 bopd. 6% wtr.

Co.

Lse.

No.

Sec.

T.

R.