


FORM 51 25M18-50 WESTERN **C.W.W.C.** KANSAS Barton
Section 20 Township 16 Range 11-W
Well No. #1 Schmidt
Company Harms & Knight

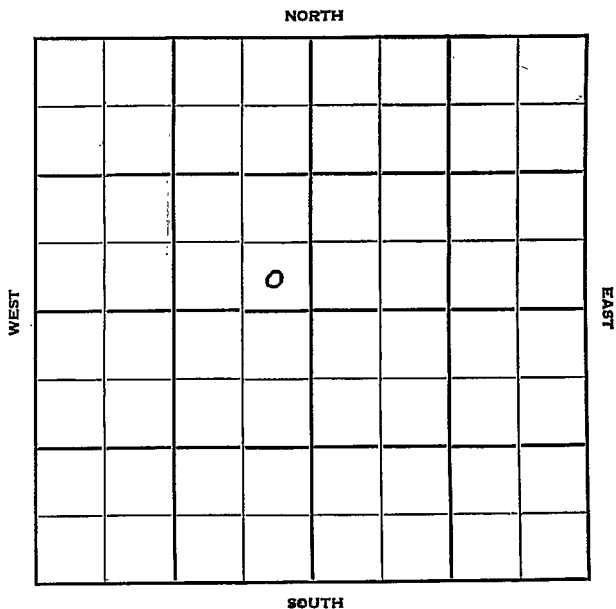

O.W.W.O.SAS
16

Barton

11-W

Sec. 20

Twp.

R.

Well No. #1 Schmidt

Farm

Harms & Knight

Company

Kraft-Pruse

Contractor

Ft. from N. Line

330

Ft. from S. Line


330

Ft. from E. Line

Ft. from W. Line

SE SE NW

Sinclair Farmout

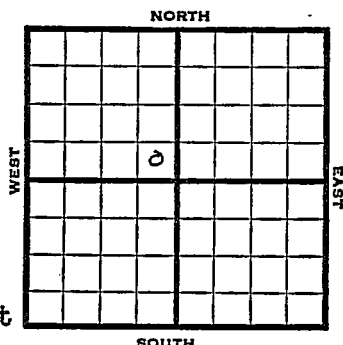

1950

Elev. 1869' REPORT

11/8

Spud 11-4-50

8" @ 208

WOC

1951

1/17

Spud 11-4-50

Oil Well TD 3304

8" @ 208 Douglas Sand 2949-54

DST 2929-54 opn 1/2 hr Rec. 170' oily mud Lans. 3002'

Arb. 3299-3302 5" @ 3300

TD 3304 B/3 boph P/60 bopd

Comp. 43 bopd

COMPLETED

1954

1/20

O.W.W.O.

Oil Well

TD 3304'

OTD 3304'

5" @ 3300'

KC 3002', Arb 3299', Doug sd. 2949'

PB 3260' perf 3188-98 1000 A PB

2994 24/ 2957-65 sd-frac

Comp 192 bopd.

FIRST REPORT

COMPLETED

County Barton State KansasSec. 20 (Blk.) 16 (Sur.) 11W Map No.Operator Harms & KnightWell No. 1 Farm SchmidtElev. Location SE SE NW

0


FIRST REPORT

330 Ft. From S Line NW330 Ft. From E Line Quarter1st. Report NOV 8 1950

Completion

Remarks Sinclair farmoutSpudding Date 11-4-50Drlg. Data Kraft-Prusa Pool8" @ 208 WOC

County Barton State Kansas
 Sec. 20 (Blk. 16 (Sur. 11W Map No.
 Twp.) Rge.)
 Operator Harms & Knight
 Well No. 1 Farm Schmidt
 Elev. 1869 Location SE SE NW

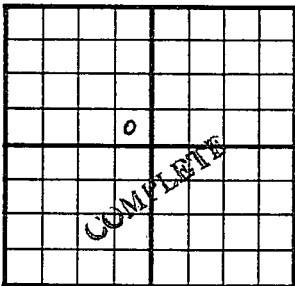

330 Ft. From S Line NW
330 Ft. From E Line Quarter
 Ist. Report _____
 Completion JAN 17 1951
 Remarks Kraft-Prusa Pool
 Spudding Date 11-4-50

Drlg. Data Oil well TD 3304
8" @ 208 Douglas sand 2949-54
DST 2929-54 open $\frac{1}{2}$ hr. Rec. 170' oily
mud Lans. 3002 Arb. 3299-3302 5" @ 3300
TD 3304 B/ 3 boph P/ 60 bopd
Comp. 43 bopd

J. G. McGEHEE