
FORM 51 25M 3-49 PETROL Barton KANSAS

Section 20 Township 16 Range 11W

Well No. #7 Peter Schmidt

Company Sinclair Oil & Gas

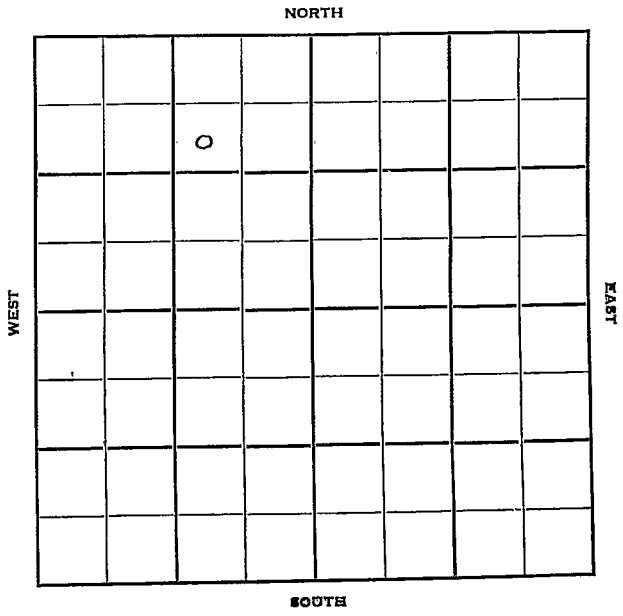

FORM 252-B
10M 11-50 PETROL

Barton

KANSAS

Sec. 20 Twp. 16 R. 11 W ✓

Well No. # 7 Peter Schmidt Farm

Sinclair Oil & Gas Company

Contractor

Kraft-Prusa Pool


990 Ft. from N. Line

Ft. from S. Line

990 Ft. from E. Line

Ft. from W. Line

SW NE NW

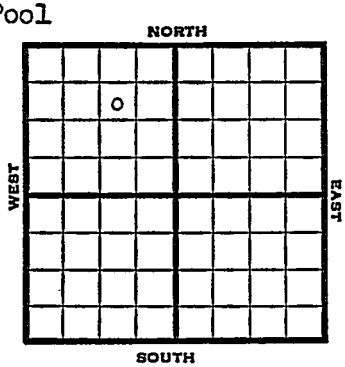

1951	Elev. 1867' REPORT
8/15	Location
9/12	Spud 8-17-51 Oil well TD 3312' 10" @ 270 Top 2655' Heeb 2907' Tor. 2925' Doug 2937' Br. lime 3003' KC 3023' Cong. 3298' Arb. 3305-12' DST 3308-12 open 1 hr. rec 50' OCM 5" @ 3305' CO to 3306' Comp. 50 BOPD COMPLETED

FORM 275 FOR SALE BY KANSAS BLUE PRINT CO.


County Barton State Kansas

Sec. 20 (Blk., Twp.) 16 (Sur., Rge.) 11W Map No.

Operator Sinclair Oil & Gas

Well No. 7 Farm Peter Schmidt

Elev. Location SW NE NW

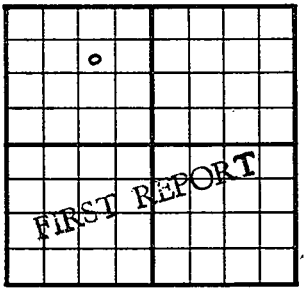

990 Ft. From N Line NW

990 Ft. From E Line Quarter

1st. Report AUG 15 1951

Completion

Remarks

Spudding Date

Drlg. Data Kraft-Prusa Pool

Location

J. E. TYRA

FORM 275 FOR SALE BY KANSAS BLUE PRINT CO.


County Barton State Kansas

Sec. 20 (Blk. Twp.) 16 (Sur. Rge.) 11W Map No.

Operator Sinclair Oil & Gas

Well No. 7 Farm Peter Schmidt

Elev. 1867 Location SW NE NW

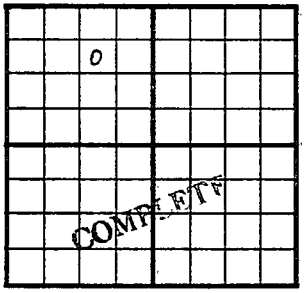

990 Ft. From N Line NW

990 Ft. From E Line Quarter

Ist. Report

Completion SEP 1 2 1951

Remarks Kraft-Prusa Pool

Spudding Date 8-17-51

Drlg. Data Oil well TD 3312

10" @ 270 Top. 2655 Heeb. 2907

Tor. 2925 Doug. 2937 Br. lime 3003

KC 3023 Cong. 3298 Arb. 3305-12

DST 3308-12 open 1 hr. Rec. 50' ocm

5" @ 3305 CO to 3306 Comp. 50 bopd

J. E. TYRA