

KANSAS


Barton

Form 51-5M-7-39-Palace,

Section 20 Township 16 Range 11-W

Well No. #2 Peter Schmitt

Company Sinclair Prairie

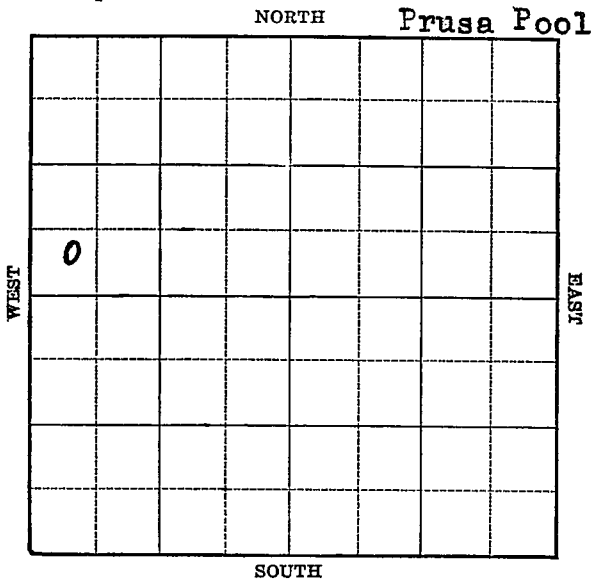

Map No. 55 Sec. 20 Twp. 16 R. 11W

Well No. 2 Peter Schmitt

Sinclair Prairie

Company

Contractor

ABANDONED

SW NW

SECTION PLAT

_____ Ft. from N. Line

440 Ft. from S. Line

_____ Ft. from E. Line

440 Ft. from W. Line

PRUSA POOL

Location _____

RECORD

Rig up _____

Cased _____ in., _____ ft.

Drilling and Remarks:

Sand _____

Gas _____

Oil _____

Total Depth 332

Ce & 2321

Water.

PRODUCTION

1st 24 hrs. Nat. _____

1st 24 hrs. after shot _____

Gas _____ Cu. Ft.

Dry Hole _____

Abandoned _____

Date

MAR 27 1940 19

S. J. LEWIS

Scout