FORM 51


Barton

KANSAS

Section 21 Township 16 Range 11W

Well No. #5 Laudick

Company Sinclair Oil Company

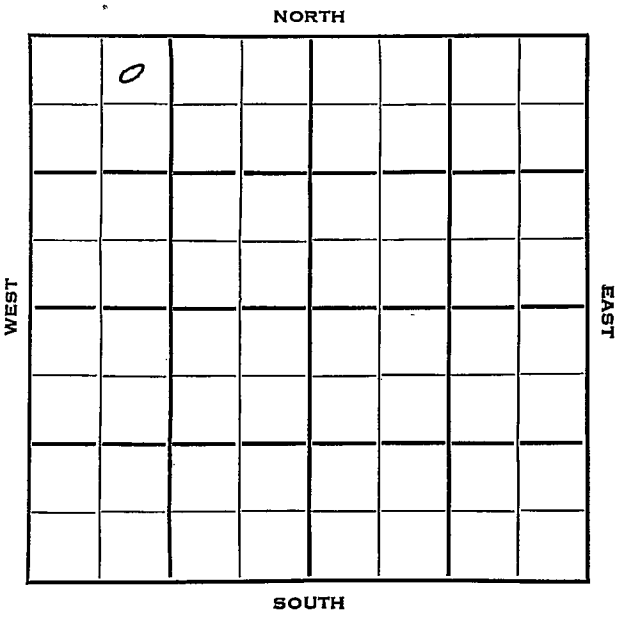

FORM 252-B

Barton KANSAS

Sec. 21 Twp. 16 R. 11 W

Well No. # 5 Laudick Farm

Sinclair Company

Contractor


330 Ft. from N. Line

Ft. from S. Line

Ft. from E. Line

990 Ft. from W. Line

NE NW NW

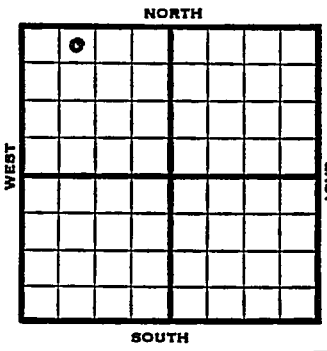

1953	Elev. 1884' REPORT
3/11	Spud 3-8-53 9-5/8" @ 358 Drlg. 805'
3/19	DST in Doug 2942-90', 1 hr, 25' M Arb. 3301' TD 3304' Schl
3/26	CO 3304, FU 1000' oil 1 hr., S/37 BO 2 hrs., 1500' OB S/66 BO 6 hrs. 5" @ 3299'
4/2	NR
4/8	Spud 3-8-53 Oil Well TD 3304 ' 9-5/8" @ 358' Top 2663, Heeb 2911, Tor 2929, Doug 2940, DST 2942-90 open 1 hr. Rec 25' mud, Lans 3025, Arb 3298 TD 3304 5" @ 3299' CO to 3304 FU 1000' oil 1 hr. S/ 37 bo 2 hr. S/ 66 bo 6 hr. Comp. 525 bopd **COMPLETED**

FORM 275 FOR SALE BY KANSAS BLUE PRINT CO.


County Barton State Kansas

Sec. 21 (Blk. Twp.) 16 (Sur. Rge.) 11W Map No.

Operator Sinclair

Well No. 5 Farm Laudick

Elev. Location NE NW NW

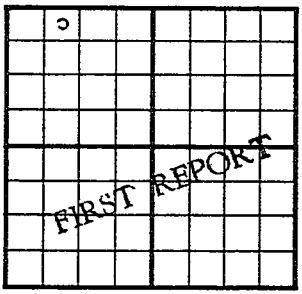

330 Ft. From N Line NW

990 Ft. From W Line Quarter

1st. Report MAR 1 1 1953

Completion

Remarks

Spudding Date 3-8-53

Drlg. Data

9 5/8" @ 358 drlg. 805

J. G. McGEHEE

FORM 275 FOR SALE BY KANSAS BLUE PRINT CO.


County Barton State Kansas

Sec. 21 (Blk. Twp.) 16 (Sur. Rge.) 11W Map No.

Operator Sinclair

Well No. 5 Farm Laudick

Elev. 1884 Location NE NW NW

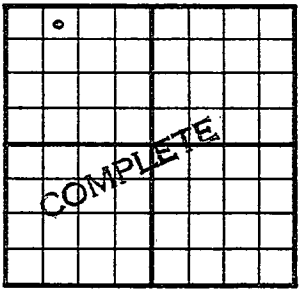

330 Ft. From N Line NW

990 Ft. From W Line Quarter

1st. Report

Completion APR 8 1953

Remarks

Spudding Date 3-8-53

Drlg. Data Oil well TD 3304

9 5/8" @ 358 Top. 2663 Heeb. 2911

Tor. 2929 Doug. 2940 DST 2942-90

open 1 hr. Rec. 25' mud Lans. 3025

Arb. 3298 TD 3304 5" @ 3299 CO to 3304

FU 1000' oil 1 hr. S/ 37 bo 2 hr.

S/ 66 bo 6 hr. Comp. 525 bopd

J. G. McGEHEE