
Form 51—5M—11-38—Palace

Barton KANSAS

Section 21 Township 16 Range 11-W

Well No. #1 Henry Laudick

Company Sinclair Prairie

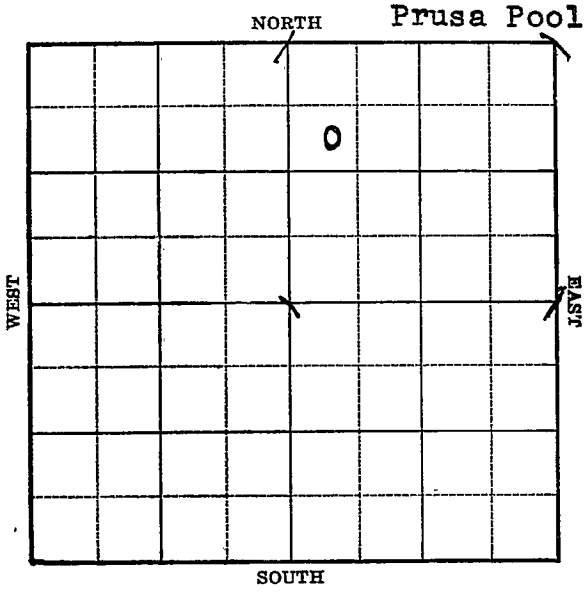

FORM 252-A 5M 10-38 KANSAS Barton

Sec. 21 Twp. 16 R. 11-W

Well No. #1 Henry Laudick Farm

Sinclair-Prairie Company

(Prusa)


990 Ft. from N. Line

Ft. from S. Line

Ft. from E. Line

440 Ft. from W. Line

Elev. 1890'

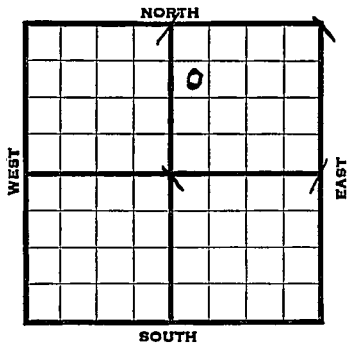

1939	REPORT
3/15	Mat'l.
3/24	10" - 125' WOC.
3/31	Anhy 775' Drlg. 2167'
4/7	Lans. 3040' S. O. 3141-60'
	B.K.C. 3329' Cherty Cong. 3339
	Reaming.
4/12	Arb. 3358'
	T. D. 3363'
	S. S. O.
	ABANDONED

Form 26—1M Bks.—2-29 Barton KANSAS

Map No. 55 Sec. 21 Twp. 16 R. 11W

Well No. 1 Henry Laudick

Sinclair Prairie Company

Contractor

FIRST REPORT

SW NW NE


990 Ft. from N. Line

_____ Ft. from S. Line

_____ Ft. from E. Line

440 Ft. from W. Line

SECTION PLAT

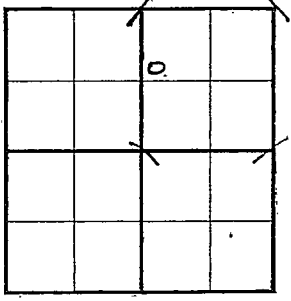

Prusa Pool

Location _____

Rig up _____

Drilling and Remarks:

Matl.

RECORD

Cased _____ in., _____ ft.

Sand _____

Gas _____

Oil _____

Total Depth _____

PRODUCTION

1st 24 hrs. Nat. _____

1st 24 hrs. after shot _____

Gas _____ Cu. Ft.

Dry Hole _____

Abandoned _____

Date

MAR 15 1939 19____ D. Hatfield Scout

Form 26—1M Bks.—2-29

KANSAS

Barton

Map No. 57 Sec. 21 Twp. 16 R. 11W

Well No. 1 Henry Laudick

Sinclair Prairie Company

Contractor

ABANDONED

SW NW NE

990 Ft. from N. Line


Ft. from S. Line

Ft. from E. Line

440 Ft. from W. Line

PRUSA POOL

SECTION PLAT

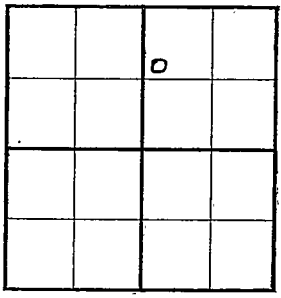

Location

Rig up

Drilling and Remarks:

550

D & A

RECORD

Cased in., ft.

Sand Arb 3358

Gas

Oil

Total Depth 3363

PRODUCTION

1st 24 hrs. Nat.

1st 24 hrs. after shot

Gas Cu. Ft.

Dry Hole

Abandoned

Date

APR 12 1939 19

H. D. Hatfield Scout