KANSAS

Form 51—5M—7-40—Palace


Barton

Section 29 Township 16 Range 11-W

Well No. #3 Esfeld

Company Derby Oil

NORTH Prusa Pool

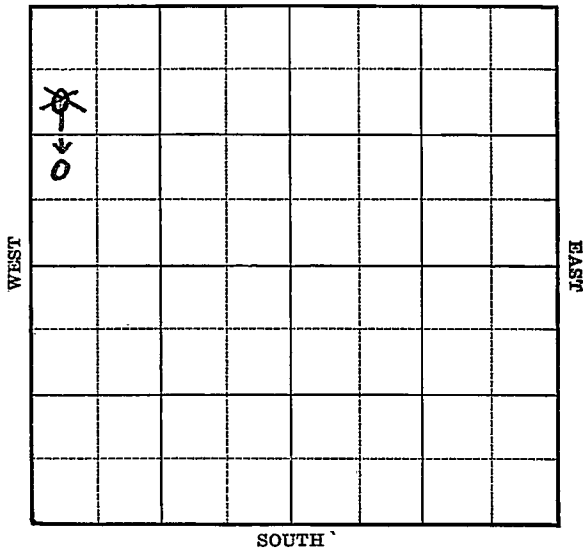

KANSAS Barton

FORM 252-A 5M 2-40

Sec. 29 Twp. 16 R. 11-W

Well No. #3 Esfeld Farm

Derby Oil Company

(Prusa)


~~990~~ Ft. from N. Line

990 Ft. from S. Line

Ft. from E. Line

330 Ft. from W. Line

Elev. 1881

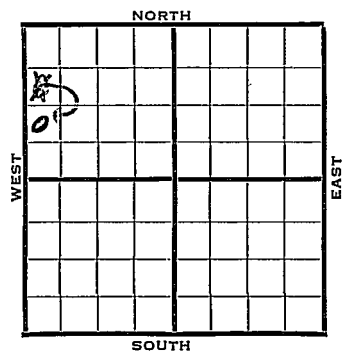

1940	REPORT
7/31	Cellar.
8/8	"
8/14	7" @ 566' Drlg. 1820'
8/22	Douglas sand 2959-64'
	Lans. 3029' Basal sand 3292-94'
	T.D. 3294'
8/29	4" - 3293' RUST.
9/5	" " "
9/12	P.B. to 3245'
9/19	" " "
9/26	" " "
10/2	Basal sand 3292'
	4" - 3293'
	Lans. 3029'
	T.D. 3294'
	P.B. to 3245'
	144 shots 2958-3065'
	3000 acid.
	Potential 68 bbls., pump.
	COMPLETED

Form 26—200 Bks.—1-40—Palace Barton KANSAS

Map No. 55 Sec. 29 Twp. 16 R. 11W

Well No. 3 Esfeld

Derby Oil Company

FIRST REPORT Contractor

SW NW NW

990 Ft. from N. Line


_____ Ft. from S. Line

_____ Ft. from E. Line

330 Ft. from W. Line

PRUSA POOL

SECTION PLAT

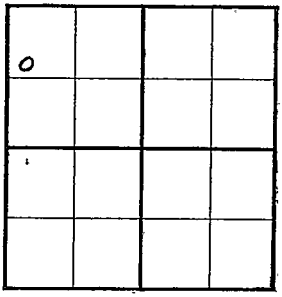

Location _____

Rig up _____

Drilling and Remarks:

Cellar

RECORD

Cased _____ in., _____ ft.

Sand _____

Gas _____

Oil _____

Total Depth _____

PRODUCTION

1st 24 hrs. Nat. _____

1st 24 hrs. after shot _____

Gas _____ Cu. Ft.

Dry Hole _____

Abandoned _____

Date

JUL 31 1940 19

S. J. LEWIS Scout

Form 26—200 Bks.—1-40—Palace

Barton KANSAS

Map No. Sec. 29 Twp. 16 R. 11W

Well No. 3 Esfeld

Derby Oil Company

CORRECTION Contractor

NW SW NW

Ft. from N. Line


990 Ft. from S. Line

Ft. from E. Line

330 Ft. from W. Line

PRUSA POOL

SECTION PLAT

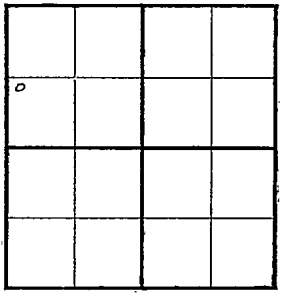

Location

Rig up

Drilling and Remarks:

Reported

SW NW NW

RECORD

Cased in., ft.

Sand

Gas

Oil

Total Depth

PRODUCTION

1st 24 hrs. Nat.

1st 24 hrs. after shot

Gas Cu. Ft.

Dry Hole

Abandoned

Date

AUG 14 1940

S. J. LEWIS Scout

Form 26—200 Bks.—1-40—Palace Barton KANSAS

Map No. 55 Sec. 29 Twp. 16 R. 11W

Well No. 3 Esfeld

Derby Oil Company

Contractor

COMPLETED

NW SW NW

Ft. from N. Line


990 Ft. from S. Line

Ft. from E. Line

330 Ft. from W. Line

PRUSA POOL

SECTION PLAT

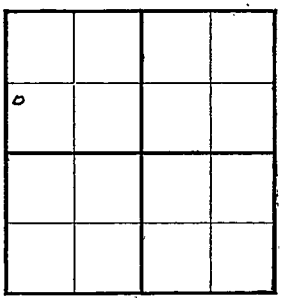

Location

Rig up

Drilling and Remarks:

Base Sol 3292.
4" @ 3293
Lans 3029
PB 3245.
1st Shots 2958-3065
3000 acid
Pump 68 BO.

RECORD

Cased in., ft.

Sand

Gas

Oil

Total Depth 3294

PRODUCTION

1st 24 hrs. Nat.

1st 24 hrs. after shot

Gas Cu. Ft.

Dry Hole

Abandoned

Date

OCT 2 1940 19

S. J. LEWIS Scout