


*Barton*

Map No. *15* Sec. *25* Twp. *17* R. *15W*

Well No. *1* (Boyle) Farm  
*Phillips Pet* Company

NORTH

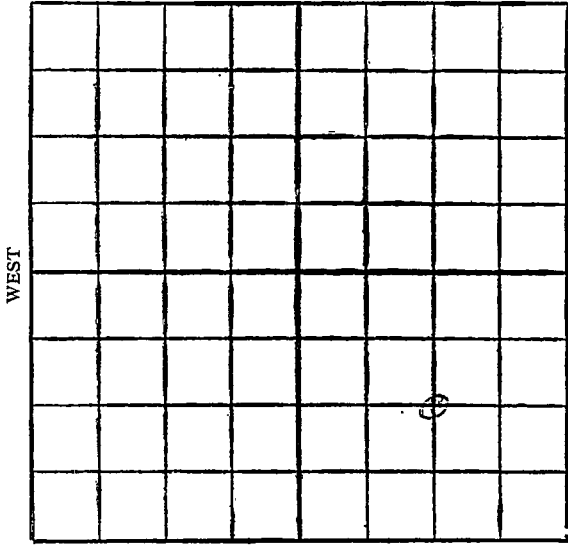

SOUTH

*1982*

Location .....

Rig Up.....

Drilling Remarks

Drilling Remarks

.....

.....

RECORD

PRODUCTION

Cased..... in. .... ft.

Sand .....

Gas .....

Oil .....

Total Depth.....

1st 24 hrs. Nat.....

1st 24 hrs. after shot.....

Gas..... cu. ft.

Dry Hole.....

Abandoned.....

Barton

Map No. Kansas Sec. 25 Twp. 17 R. 15<sup>w</sup>

Well No. 1 Farm


Phillips Pet Company

..... Ft. from N. Line

1320 Ft. from S. Line

1320 Ft. from E. Line

..... Ft. from W. Line

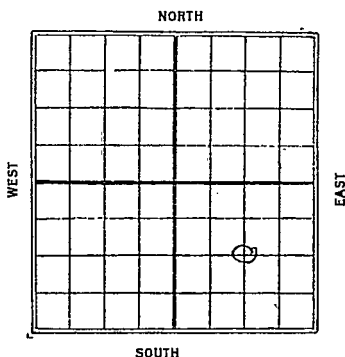

Date / REPORT

1926	
12/21	Location
12/29	same
1927	
1/5	Rog
1/12	Rig
1/19	Rigging up
1/26	Spud
2/2	
2/9	Spud S.D., spud water well
2/16	Spud
2/23	Drlg 400
3/2	" 530
3/9	" 620
3/16	" 730
3/23	" 1000
3/30	" 1240
4/6	" 1925
4/13	" 2275
4/20	" 2510
4/27	" 2885
5/4	" 3210
5/11	" 3275
5/18	T.D. 3400 - fishing tools

6/1 - Drelg 3560-  
6/8 - Sand 3630-35 - H.F.W.  
Drelg 3635-  
6/15 - " 3650  
6/22 - " 3750  
6/29 - " 3830  
7/13 - D. & A. 4003'

Map No. *KANSAS* Sec. *25* Twp. *17* R. *15W*

Well No. *1*

*Phillips P & O.* Company

Contractor

SECTION PLAT


----- Ft. from N. Line

*1320* Ft. from S. Line

*1320* Ft. from E. Line

----- Ft. from W. Line

FIRST REPORTS

Location *✓*

Rig up -----

Drilling and Remarks:

RECORD

Cased ----- in., ----- ft.

Sand -----

Gas -----

Oil -----

Total Depth -----

PRODUCTION

1st 24 hrs. Nat. -----

1st 24 hrs. after shot -----

Gas ----- Cu. F

Dry Hole -----

Abandoned -----

Date

*1* 1926  
*192*

S. J. LEWIS

S

Map No. KANSAS Sec. 25 Twp. 17 R. 15W

Well No. 1 Boyle

Phillips P & O Company

Contractor

SECTION PLAT

----- Ft. from N. Line

1320 Ft. from S. Line

1320 Ft. from E. Line

----- Ft. from W. Line


**ABANDONED**

Location -----

Rig up -----

Drilling and Remarks:

T 4003  
D & A

RECORD

Cased ----- in., ----- ft.

Sand -----

Gas -----

Oil -----

Total Depth -----

PRODUCTION

1st 24 hrs. Nat. -----

1st 24 hrs. after shot -----

Gas ----- Cu. Ft.

Dry Hole -----

Abandoned -----

Date

JUL 13 1927

192

S. J. LEWIS

Scout

Barton

MAP NO. KANSAS SEC. 75 TWP. 17S R. 15W

WELL NO. P. O. C. 1

COMPANY \_\_\_\_\_

CONTRACTOR \_\_\_\_\_

*no wall mwp*

SECTION PLAT


\_\_\_\_\_ FT. FROM N. LINE

\_\_\_\_\_ FT. FROM S. LINE

\_\_\_\_\_ FT. FROM E. LINE

\_\_\_\_\_ FT. FROM W. LINE

ABANDONED

LOCATION \_\_\_\_\_

RIG UP \_\_\_\_\_

DRILLING AND REMARKS:

*granite*

RECORD

CASED \_\_\_\_\_ IN. \_\_\_\_\_ FT.

SAND \_\_\_\_\_

GAS \_\_\_\_\_

OIL \_\_\_\_\_

TOTAL DEPTH 6002

PRODUCTION

1ST 24 HRS. NAT. \_\_\_\_\_

1ST 24 HRS. AFTER SHOT \_\_\_\_\_

GAS \_\_\_\_\_ CU. FT.

DRY HOLE

ABANDONED

DATE

*8/11 1927*

SCOUT