

Section 5 Township 18 Range 1 WWell No. # 1 HenneCompany Aro Equip. & NACC

16

NORTH

WEST

							0

EAST

SOUTH

McPherson KANSAS

SEC.	TWP.	R.
5	18	1W ✓

WELL NO.

1 Henne

FARM

COMPANY

Aro Equip. & N A C C

CONTRACTOR

Pam-Kar

Wildcat


_____ Ft. from N. Line

330 _____ Ft. from S. Line

330 _____ Ft. from E. Line

_____ Ft. from W. Line

SE SE SE

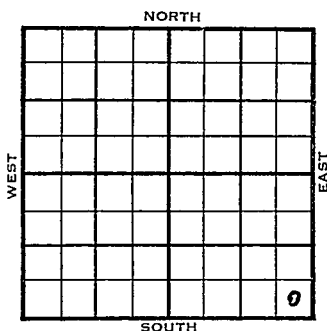

1953

ELEVATION

1404'

REPORT

11/18

RUR

12/9

Spud 11-16-53 D & A TD 2780

8" @ 154 Lans 2160 Miss 2750

DST 2760-64 open 1 hr rec 35' wtr. mud
1' oil

DST 2760-80 open 3/4 hr. rec 87' wtr.

580# TD 2780' D & A

ABANDONED

J. G. McGEHEE

J. G. McGEHEE