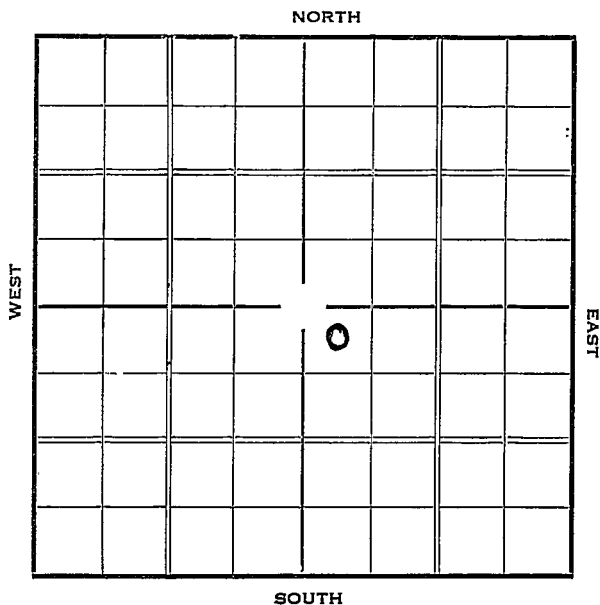


Section 23 Township 17 Range 15-WWell Number 1 - AxmanCompany Gulf

Map No. 73 Sec. 23 Twp. 17 R. 15^WWell No. 1 - AkmanGulf Company

Contractor

FIRST REPORT

SECTION PLAT

		0	

Special

330 Ft. from N. Line

_____ Ft. from S. Line

_____ Ft. from E. Line

330 Ft. from W. Line

Location _____

Rig up _____

Drilling and Remarks:

BRR

RECORD

Cased _____ in., _____ ft.

Sand _____

Gas _____

Oil _____

Total Depth _____

PRODUCTION

1st 24 hrs. Nat. _____

1st 24 hrs. after shot _____

Gas _____ Cu. Ft.

Dry Hole _____

Abandoned _____

Date

MAY 19 1937

19

H. D. Hatfield Scout

Barton KANSASMap No. _____ Sec. *23* Twp. *17* R. *15*^WWell No. *1 - Adman**Gulf* Company

Contractor _____

ABANDONED

330 Ft. from N. Line

_____ Ft. from S. Line

_____ Ft. from E. Line

330 Ft. from W. Line

SECTION PLAT

		0	

Location _____

Rig up _____

Drilling and Remarks:

D & A

RECORD

Cased _____ in., _____ ft.

Sand *511 3549*

Gas _____

Oil _____

Total Depth *3589*

PRODUCTION

1st 24 hrs. Nat. _____

1st 24 hrs. after shot _____

Gas _____ Cu. Ft.

Dry Hole _____

Abandoned _____

Date

E. D. Hatfield

Scout

JAN 3 6 1919