KANSAS


Form 51—5M—7-39—Palace

Barton

Section 21 Township 17 Range 15-W

Well No. #1 Pospishel "A"

Company Transwestern Oil

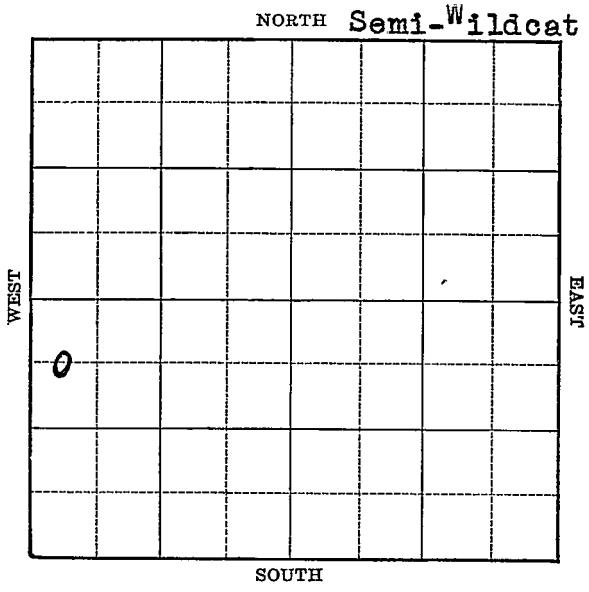

FORM 252-A 5M KANSAS Barton

Sec. 21 Twp. 17 R. 15-W

Well No. #1 Pospishel "A" Farm

Transwestern Oil Company

(Semi-Wildcat)


660 Ft. from N. Line

_____ Ft. from S. Line

_____ Ft. from E. Line

330 Ft. from W. Line

Elev. 2040

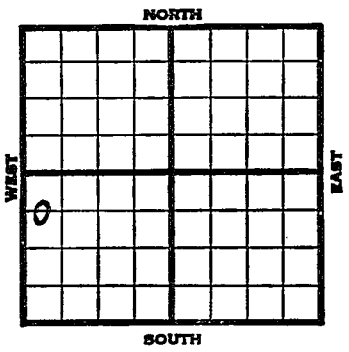


| 1939 | REPORT |
|---|---|
| 9/27 | Rotary |
| 10/5 | 16" - 52' Anhy. 1066' |
| | Drlg. 1850' |
| 10/12 | Drlg. 2900' |
| 10/19 | Arb. 3576½' 7" - 3576½' |
| | T.D. 3577' RUST. |
| 10/26 | T.D. 3590' 600' oil 1½ hours. |
| 11/2 | 1000 acid. Would not take. |
| | |
| 11/8 | Arb. 3376½' |
| | T.D. 3590' |
| | 7" - 3576½' |
| | 2000 acid. |
| | Pump 291 bbls. |
| | |
| | COMPLETED |

Form 26—1M Bks.—2-29 Barton KANSAS

Map No. _____ Sec. 21 Twp. 17 R. 15W

Well No. 1 Pospishel "A"

Transwestern Oil Company

_____ Contractor

FIRST REPORT

C W½ NW SW

660 Ft. from N. Line


_____ Ft. from S. Line

_____ Ft. from E. Line

330 Ft. from W. Line

SEMI-WILDCAT

SECTION PLAT

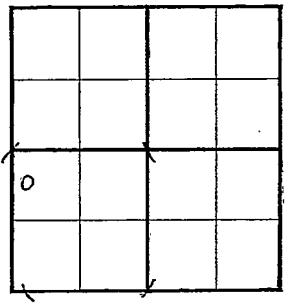

Location _____

Rig up _____

Drilling and Remarks:

Rotary

RECORD

Cased _____ in., _____ ft.

Sand _____

Gas _____

Oil _____

Total Depth _____

PRODUCTION

1st 24 hrs. Nat. _____

1st 24 hrs. after shot _____

Gas _____ Cu. Ft.

Dry Hole _____

Abandoned _____

Date

SEP 27 1939 19 S. J. LEWIS Scout

Form 26—1M Bks.—2-29 Barton KANSAS

Map No. 73 Sec. 21 Twp. 17 R. 15W

Well No. 1 Pospishel "A"

Transwestern Oil Company

Contractor

COMPLETED

C W½ NW SW

660 Ft. from N. Line


Ft. from S. Line

Ft. from E. Line

330 Ft. from W. Line

SEMI-WILDCAT

SECTION PLAT

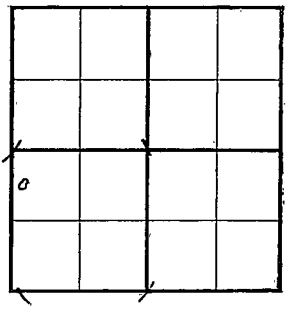

Location

Rig up

Drilling and Remarks:

Ar @ 3576½

7" @ 3576½

2000 Acid

Pump. 291 Bbls

RECORD

Cased in., ft.

Sand

Gas

Oil

Total Depth 3590

PRODUCTION

1st 24 hrs. Nat.

1st 24 hrs. after shot

Gas Cu. Ft.

Dry Hole

Abandoned

Date

NOV 8 1939 19

S. J. LEWIS Scout