

Section 17 Township 35 Range 4E

Well No. #1 Dawler

Company Helmerich & Payne

NORTH

//

			0				

WEST

EAST

SOUTH

Cowley

KANSAS

Sec. 17 Twp. 35 R. 4E

Well No. #1 Dawler Farm

Helmerich & Payne Company

Contractor

Pudin Pool


330 Ft. from N. Line

_____ Ft. from S. Line

330 Ft. from E. Line

_____ Ft. from W. Line

NE NE SW

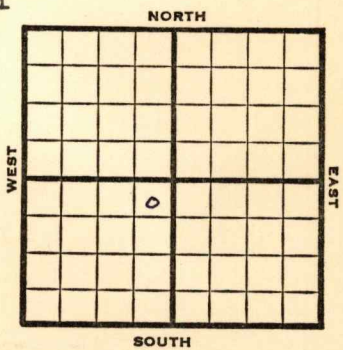

1951

Elev. 1203'

REPORT

12/5 Cellar & pits

1952
1/30

Spud 12-11-51
 Oil Well TD 3328
 10" @ 83
 Layton 2598
 Bart 3317-24
 5" @ 3317
 TD 3328
 F/70 bo 5 hr.
 Comp. F/115 bopd

COMPLETED

