


Section 17 Township 35 Range 4E

Well No. #3 Gregory

Company Helmerich & Payne

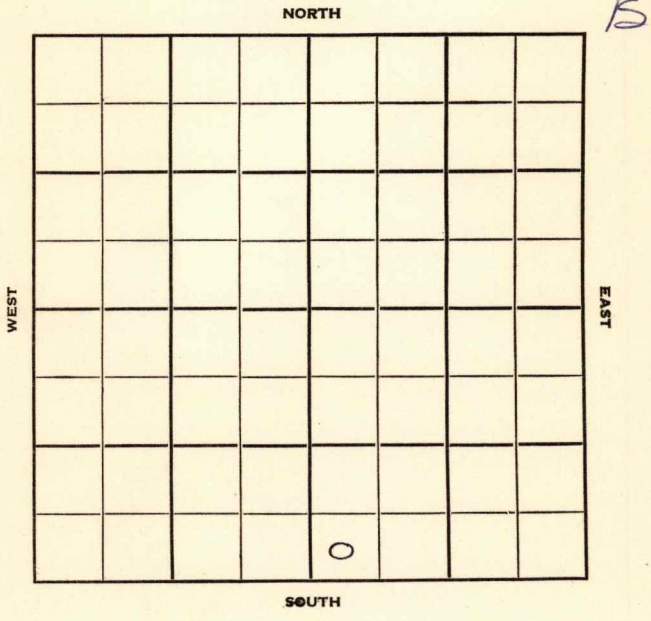

Cowley



Sec. 17 Twp. 35 R. KANSAS 4E

Well No. #3 Gregory Farm

Helmerich & Payne Company

Warren - Contr. Contractor


_____ Ft. from N. Line

330' Ft. from S. Line

_____ Ft. from E. Line

330' Ft. from W. Line

SW SW SE

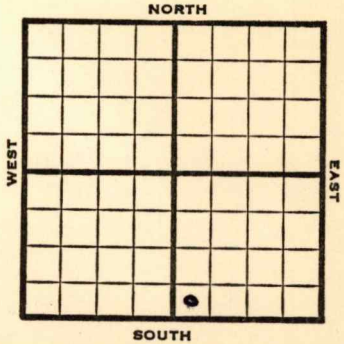

1952 **Elev. 1212'** REPORT

6/25
7/23

8" @ 169
 Spud 6-27-52
 Oil Well TD 3354'
 8" @ 169 **Bart 3321**
 5" @ 3321'
 TD 3354 PB 3347
 Hydro Comp. 316 bopd 10% wtr.

COMPLETED

