

Section 17 Township 35 Range 4E

Well No. #4 Dowler

Company Helmerich & Payne

NORTH

SOUTH

WEST

EAST

C

14

Cowley

Sec. 17 Twp. 35 R. 4E **KANSAS**

Well No. #4 Dowler Farm

Helmerich & Payne Company

Warren - Contr. Contractor


 Ft. from N. Line

330' Ft. from S. Line

330' Ft. from E. Line

 Ft. from W. Line

SE SE SW

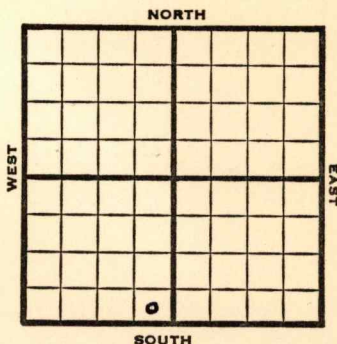

1952

Elev. 1207'

REPORT

6/25
7/23

Cellar & Pits

Spud 7-9-52

D&A TD 3404' 8" @ 164

Bart 3350

Miss 3396

TD 3404' D&A

ABANDONED

3396
1207

2189

County **Cowley** State **Kansas**
Sec. **17** (Blk. **35** (Sur. **4E** Map No.
Operator **Helmerich & Payne**
Well No. **4** Farm **Dowler**
Elev. Location **SE SE SW**

FIRST REPORT

330 Ft. From **S** Line **SW**
330 Ft. From **E** Line Quarter

1st. Report **JUN 25 1952**

Completion

Remarks

Warren - Contr.

Spudding Date

Drlg. Data

Cellar & pits

J. G. McGEHEE

County Cowley State Kansas
 Sec. 17 (Blk.) 35 (Sur.) 4E Map No.
 (Twp.)
 Operator Helmerich & Payne
 Well No. 4 Farm Dowler
 Elev. 1207 Location SE SE SW



330 Ft. From S Line SW

330 Ft. From E Line Quarter

1st. Report

Completion JUL 23 1952

Remarks

Warren - Contr.

Spudding Date 7-9-52

Drig. Data D & A TD 3404

8" @ 164 Bart. 3350 Miss. 3396

TD 3404

D & A

J. G. McGEHEE