


Section 2 Township 35 Range 5-E

Well No. #1 Dunn Est.

Company Morgan Petroleum

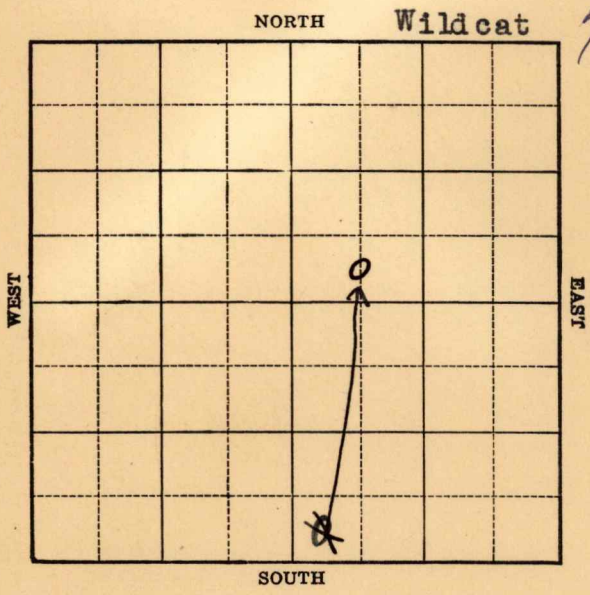

Sec. 2 Twp. 35 R. 5-E

Well No. #1 Dunn Est. Farm

Morgan Petr. Company

(Wildcat)


_____ Ft. from N. Line

330 Ft. from S. Line

_____ Ft. from E. Line

660
~~330~~ Ft. from W. Line

Elev. 1206

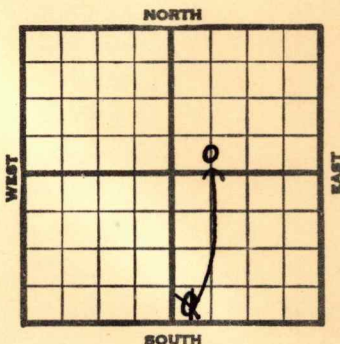

REPORT	
1940	
2/14	Cellar.
2/23	Derrick.
2/29	"
3/8	"
3/14	"
3/21	"
3/28	"
4/4	10" - 40' WOC.
4/12	Drlg. 2100'
4/18	Oswego 2718'
	TD 2816' SD.
4/25	Miss. 3141'
	Drlg. 3191'
5/2	Drlg. 3310' in Miss.
5/8	Miss. 3141'
	Base Miss. 3511'
	Arb. 3565'
	Total depth 3603'
	ABANDONED

3141
1206

1935

3565
1206

2359

Cowley

KANSAS

Map No. 2 Sec. 2 Twp. 35 R. 5E

Well No. 1 Dunn Est.

Morgan Petroleum Company

Contractor

FIRST REPORT

SECTION PLAT

SW SE

_____ Ft. from N. Line

330 Ft. from S. Line

_____ Ft. from E. Line

330 Ft. from W. Line

WILDCAT

Location _____

Rig up _____

Drilling and Remarks:

Cellar

RECORD

Cased _____ in., _____ ft.

Sand _____

Gas _____

Oil _____

Total Depth _____

PRODUCTION

1st 24 hrs. Nat. _____

1st 24 hrs. after shot _____

Gas _____ Cu. Ft.

Dry Hole _____

Abandoned _____

Date

FEB 14 1940

19

S. J. LEWIS

Scout

Cowley

KANSAS

Map No. 2 Sec. 2 Twp. 35 R. 5E

Well No. 1 Dunn Estate

Morgan Petroleum Company

CORRECTION Contractor

C S L SW NE


SECTION PLAT

 Ft. from N. Line

330 Ft. from S. Line

 Ft. from E. Line

660 Ft. from W. Line

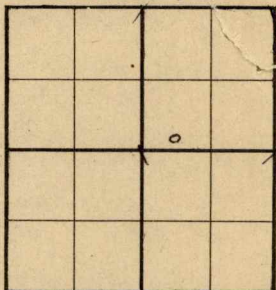

WILDCAT

Location

RECORD

Rig up

Drilling and Remarks:

Cased in., ft.

Sand

Gas

Oil

Total Depth

Reported

SW SE

PRODUCTION

1st 24 hrs. Nat.

1st 24 hrs. after shot

Gas Cu. Ft.

Dry Hole

Abandoned

Date

FEB 28 1940 19

S. J. LEWIS Scout

Cowley

KANSAS

Map No. 2 Sec. 2 Twp. 35 R. 5E

Well No. 1 Dunn Est.

Morgan Petroleum Company

Contractor

ABANDONED

SECTION PLAT

C S L SW NE

Ft. from N. Line

330 Ft. from S. Line

Ft. from E. Line

660 Ft. from W. Line

WILDCAT

Location _____

Rig up _____

Drilling and Remarks:

Miss 3141

B Miss 3511

Cr 3565

RECORD

Cased _____ in., _____ ft.

Sand _____

Gas _____

Oil _____

Total Depth: 3603

PRODUCTION

1st 24 hrs. Nat. _____

1st 24 hrs. after shot _____

Gas _____ Cu. Ft.

Dry Hole _____

Abandoned _____

Date

MAY 8 1940

S. J. LEWIS Scout