


KANSAS

FORM 51 25M 3-49 PETROL Cowley

Section 4 Township 35 Range 5E

Well No. #1 Warren

Company Carter Oil

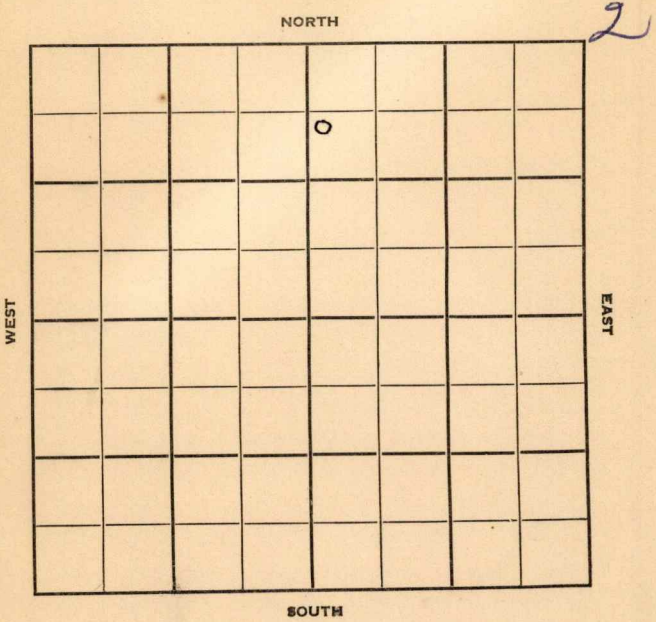

Cowley

KANSAS

Sec. 4 Twp. 35 R. 5E ✓

Well No. #1 Warren Farm

Carter Oil Company

Wildcat Contractor


825' Ft. from N. Line

Ft. from S. Line

Ft. from E. Line

330' Ft. from W. Line

NW SW NW NE

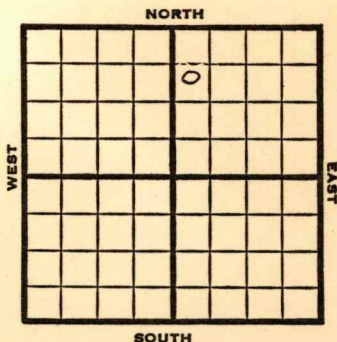

1951

Elev. 1199' REPORT

8/8

Location

9/5

Spud 8-14-51

D&A TD 3183

8-5/8" @ 127

Howard 969 Top. 1143 Heeb. 1522

Dodge 1591 Ians. 1814 Stal. 1843

Layton 2332 KC 2634 B KC 2652

Oswego 2752 Cherokeee 2878

Bart. 3061

DST 3058-70 open 1 hr. rec. 6' mud

B. Bart. 3077 Cong. 3123

DST 3070-75 open 90 min. no rec.

Cored 3075-80 rec. 5' shl.

Cored 3080-90 rec. 10' sh.

Miss. ch. 3128 Miss. lime 3131

TD 3183

D&A

ABANDONED

3128
1199
1929

County **Cowley** State **Kansas**Sec. **4** (Blk.) **35** (Sur.) **5E** Map No.Operator **Carter Oil**Well No. **1** Farm **Warren**Elev. Location **NW SW NW NE**

825 Ft. From **N** Line **NE****330** Ft. From **W** Line Quarter1st. Report **AUG 8 1951**

Completion

Remarks

Spudding Date

Drlg. Data **Wilcoat****Location****J. E. TYRA**

County Cowley State Kansas
 Sec. 4 (Blk.) 35 (Sur.) 5E Map No. _____
 Operator Carter Oil
 Well No. 1 Farm Warren
 Elev. 1199 Location NW SW NW NE



825 Ft. From N Line NE
 330 Ft. From W Line Quarter
 1st. Report _____
 Completion SEP 5 1951
 Remarks Wildcat
 Spudding Date 8-14-51

Drlg. Data D & A TD 3183
8 5/8" @ 127 Howard 969 Top. 1143
Heeb. 1522 Dodge 1591 Lans. 1814
Stal. 1843 Layton 2332 KC 2634
B KC 2652 Oswego 2752 Cherokee 2878
Bart. 3061 DST 3058-70 open 1 hr.
Rec. 6' mud B. Bart. 3077 Cong. 3123
DST 3070-75 open 90 min. no rec.
Cored 3075-80 rec. 5' shl. Cored 3080-90
rec. 10' sh. Miss. ch. 3128 Miss. lime
3131 TD 3183

D & A

J. E. TYRA