


DX 78-1 Barton

KANSAS

Section 2 Township 17 Range 15W

Well No. #1 Hester

Company Iron Drlg

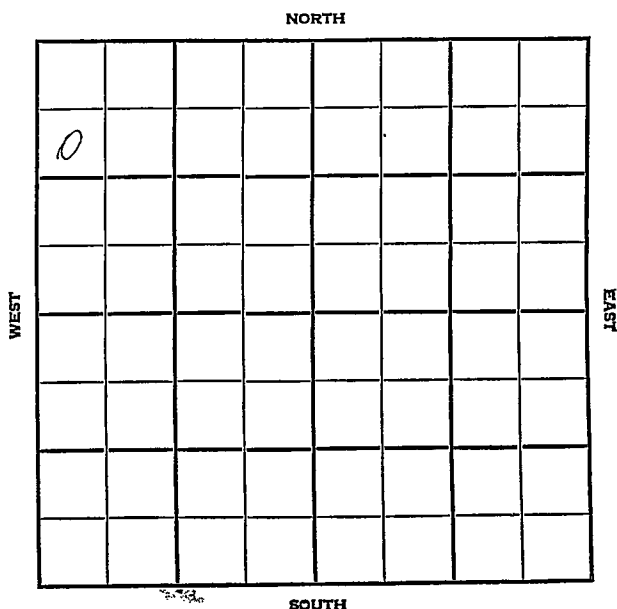

SEC.

2

TWP.

17

R.

15W

WELL NO.

#1 Hester

FARM

COMPANY

Iron Drlg.

CONTRACTOR

Co. Tools

~~WILDCAT~~


FT. FROM N. LINE

FT. FROM S. LINE

FT. FROM E. LINE

-FT. FROM W. LINE

SW NW NW

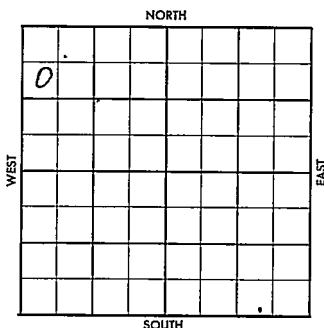

Northern Pump - DHM

1956

ELEVATION

REPORT

6-6

Comm. 6-1-56

8" @ 648

Drlg. 2502

Anh. 995'.

6-13

DST 3544-53

40 min. rec. 32' M & W

BHP 1030

TD 3580

D & A

H. 3194', Tr. 3212', Dg. 3226',

L. 3256', B.K.C. 3485', C_g1. 3500',

A. 3550:

ABANDONED

County Barton Elev. _____
 Sec. 2 Twp. 17 Rge. 15W
 Company Iron Drlg.
 FarmName Hester No. 1

TOPS	DEPTH	LOG	DATUM	Loc. in Sec.
Anh.	995			SW NW NW
Tr.				
H.				
Tr.				
Dg.				
BL.				
L.				Geol.
K.C.				Contr.
B.K.C.				Co. tools
Ce.				
C.				Pool
M.				Wildcat
M.				
K.				
Mz.				
Mq.				
V.				
S.				
S.				
A.				
R.				
Pe.				
G.				
T.D.				

0
 FIRST REPORT

JUN 6 '56

Date Comm. 6-1-56 Northern Pump - DHM
8" @ 618/ drlg. 2502

SEP 1 1956

County Barton Elev. _____
 Sec. 2 Twp. 17 Rge. 15^W
 Company Iron Drllr.
 Farm Name Hester No. 1

TOPS	DEPTH	LOG	DATUM	Loc. in Sec.
Anh.	995			SW NW 17.7
Tp.				
H.	3194			
Tr.	3212			
Dg.	3226			
Bl.				
L.	3256			Geol.
K.C.				Contr.
B.K.C.	3485			Co. tools
Ce.				
C. <u>yl</u>	3500			
M.				Pool
M.				Well cat
K.				
Mz.				
Mo.				
V.				
S.				
S.				
A.	3550			
R.				
Pe.				
G.				
Td.	3580			

ABANDONED
 JUN 13 '55

Date Comm. 6-1-56 Northern Pump - DHM
8" C 618/ ddr. 2502 JUN 17 '56
DST 3544-53 (40) rec 32' m #w
BTR 1030
TD 3580

DEA