

Section 6 Township 35 Range 5E

Well No. #1 Warren

Company Zephyr Drlg.

Wildcat

NORTH

WEST

EAST

SOUTH

14

KANSAS

Cowley County

Sec. 6 Twp. 35 R. 5E

Well No. #1 Warren Farm

Zephyr Drlg. Company

Wildcat

Ft. from N. Line

990

Ft. from S. Line


330

Ft. from E. Line

Ft. from W. Line

NE SE SW

Elev. 1161

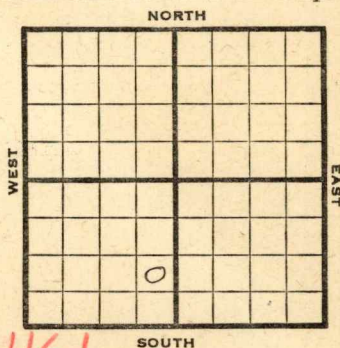

1944

R E P O R T

10/25

Location

11/1

10" @ 167

Drlg. 750

11/8

Drlg. 1515

11/16

Drlg. 2975'

11/22

Miss. 3178

TD 3215'

3178

1161

2017

ABANDONED

KANSAS

Pool Name WildcatMap No. 2 Sec. 6 Twp. 35 R. 5EWell No. 1 Warren

Zephyr Drlg


Company

FIRST REPORT

Contractor

NE SE SW

SECTION PLAT

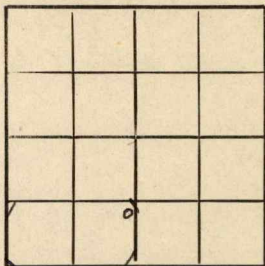

Ft. from N. Line

990 Ft. from S. Line330 Ft. from E. Line

Ft. from W. Line

Cowley

Location X

Rig up

Drilling and Remarks:

RECORD

Cased in., ft.Sand Gas Oil Total Depth

PRODUCTION

1st 24 hrs. Nat. 1st 24 hrs. after shot Gas Cu. Ft.Dry Hole Abandoned

Date

OCT 25 1944

19


S. J. LEWIS

Scout

Pool Name CowleyMap No. 7 Sec. 6 Twp. 35 R. 5EWell No. 1 WarrenZephyr Drlg. CompanyABANDONED Contractor

NE SE SW

SECTION PLAT

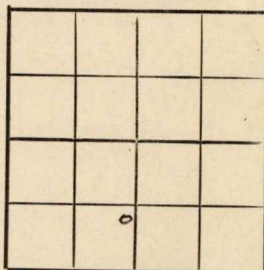 Ft. from N. Line990 Ft. from S. Line330 Ft. from E. Line Ft. from W. LineCowleyLocation Rig up

Drilling and Remarks:

Miss 8178

RECORD

Cased in., ft.Sand Gas Oil Total Depth 3215

PRODUCTION

1st 24 hrs. Nat. 1st 24 hrs. after shot Gas Cu. Ft.Dry Hole Abandoned

Date

NOV 22 1944

19

S. J. LEWIS Scout