


Section 8 Township 25 Range 5 E

Well No. # 243 Wilson

Company Cities Service

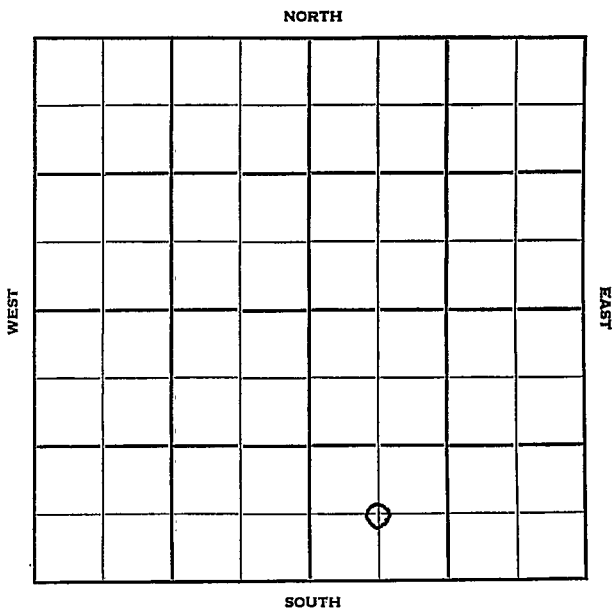

Butler
25

KANSAS

5E ✓

Sec. 8 Twp. _____ R. _____

Well No. #243 Wilson Farm _____

Cities Service Company _____

B & R Drlg. Contractor _____


_____ Ft. from N. Line

660' Ft. from S. Line

_____ Ft. from E. Line

660' Ft. from W. Line

C SW SE

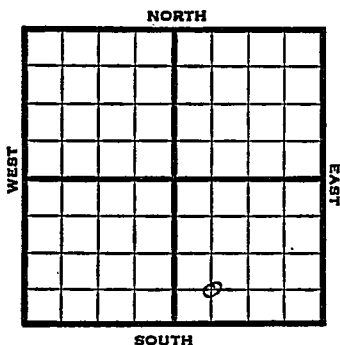

1951 Elev. 1369' REPORT

3/14 8" @ 80'

4/4 Oil Well TD 2495
8" @ 80
Arb. 2411-16
5" @ 2412
TD 2495 Comp. 110 bopd

COMPLETED

County Butler State Kansas

Sec. 8 (Blk.) 25 (Sur.) 5E Map No.

Operator Cities Service

Well No. 243 Farm Wilson

Elev. _____ Location C SW SE

| | | | | | |
|--|--|--|--|--|--|
| | | | | | |
| | | | | | |
FIRST REPORT

660 Ft. From S Line SE

660 Ft. From W Line Quarter

lst. Report MAR 14 1951

Completion _____

Remarks _____

B & R Drlg. - Contr.

Spudding Date _____

Drlg. Data _____

8" @ 80

J. E. TYRA

