


Section 7 Township 17 Range 15 W

Well No. # 1 Moore

Company Ben Brack Oil

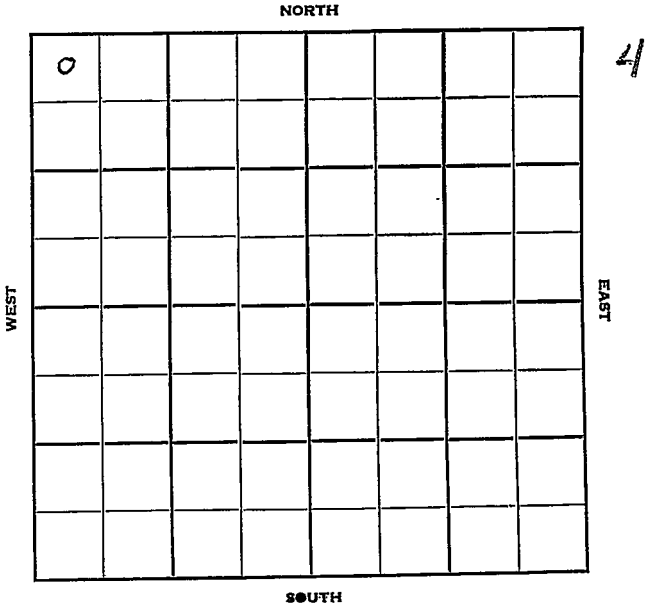

Barton

KANSAS **HOT FILE**

Sec. 7 Twp. 17 R. 15 W

Well No. # 1 Moore Farm

Ben Brack Oil Company

Contractor


Wildcat

330 Ft. from N. Line

 Ft. from S. Line

 Ft. from E. Line

330 Ft. from W. Line

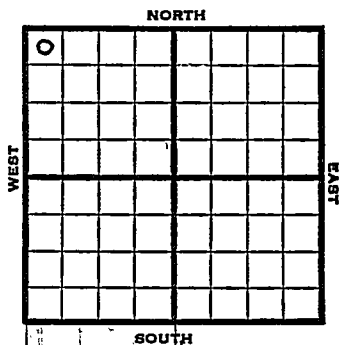

NW NW NW

Stanolind DHM

MCPC has NW of 18

1951	Elev. 2017'	REPORT
------	-------------	--------

3/28	8" @ 697' Anhy 1095' Drlg. 2325'	
------	--	--

5/16	D & A TD 3596' 8" @ 697' Anhy 1095' Heeb 3253' Tor. 3269' Lans. 3312' DST 3590-96 open $\frac{1}{2}$ hr. rec 12' HOCM 5" @ 3589' TD 3596' $8\frac{1}{2}$ GO 8 hr. 500 A B/16 BF 8 hr. 75% water SP 3592 $\frac{1}{2}$ ' B/12 GW 18 GOPH 750 A FU 200' water in hole S/18 GO 120 GWPH 500 A B/16 BF 8 hr. 75% water D & A	B KC 3533' Cong 3559' Arb. 3588'
------	--	--

ABANDONED

County Barton State KansasSec. 7 (Blk. Twp.) 17 (Sur. Rge.) 15W Map No.Operator Ben Brack OilWell No. 1 Farm MooreElev. 2017 Location NW NW NW

0							

330 Ft. From N Line NW330 Ft. From W Line Quarter1st. Report MAR 28 1951

Completion

Remarks Stanolind DHMMCPC has NW of 18

Spudding Date

Drlg. Data Wildcat8" @ 697 Anhy 1095 drlg. 2325

County Barton State Kansas
 Sec. 7 (Blk.
Twp.) 17 (Sur.
Rge.) 15W Map No.
 Operator Ben Brack Oil
 Well No. 1 Farm Moore
 Elev. 2017 Location NW NW NW

0							

330 Ft. From N Line NW
330 Ft. From W Line Quarter

1st. Report

Completion MAY 16 1951

Remarks Wildcat

Spudding Date

Drlg. Data D & A TD 3596
8" @ 697 Anhy 1095 Heeb. 3253
Tor. 3269 Lans. 3312 B KC 3533
Cong. 3559 Arb. 3588 DST 3590-96
open $\frac{1}{2}$ hr. Rec. 12' hocm 5" @ 3589
TD 3596 $8\frac{1}{2}$ go 8 hr. 500 A B/ 16 bf
8 hr. 75% water SP 3592 $\frac{1}{2}$ B/ 12 gw
18 goph 750 A FU 200' water in hole
S/ 18 go 120 gwph 500 A B/ 16 bf 8 hr.
75% water D & A

J. E. TYRA