


Barton

KANSAS
15W

Section 12 Township 17 Range 15W

Well No. #1 Chas. Rizinger

Company Sinclair Oil & Gas

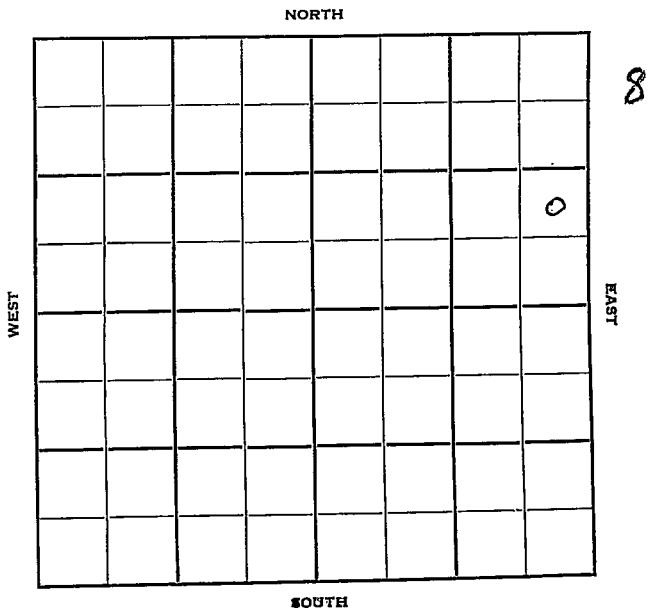

Barton

KANSAS

Sec. 12 Twp. 17 R. 15W

Well No. #1 Chas. Rizinger Farm

Sinclair Oil & Gas Company

Holm Drlg - Contr. Contractor

Leoville Pool


330' Ft. from N. Line

Ft. from S. Line

330' Ft. from E. Line

Ft. from W. Line

NE NE NE

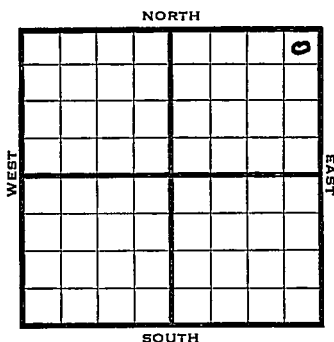

1950 Elev. 1969' REPORT

8/23 Location

10/18

Spud 8-24-50

Oil Well TD 3464'

10-3/4" @ 960' Lans. 3213'

Stain 3220-25

Arb. 3457'

7" @ 3458' TD 3463

FU 660' oil 9 hr.

1000 A S/4 1/2 BOPH DD 3464

N_o inc. Comp. 157 BOPD 10% wtr.

COMPLETED

County Barton State KansasSec. 25 (Blk. Twp.) 17 (Sur. Rge.) 11W Map No.Operator TexasWell No. 3 Farm McLeanElev. Location NE SE NE

990 Ft. From S Line NE330 Ft. From E Line Quarter1st. Report AUG 23 1950

Completion

Remarks

Spudding Date

Drlg. Data Bloomer PoolLocation

J. E. TYRA

