
~~#####~~ Cowley KANSAS

SECTION 15 TOWNSHIP 35 RANGE 5E

WELL NO. #1 Warren SWD

COMPANY W.H. Pitts

5

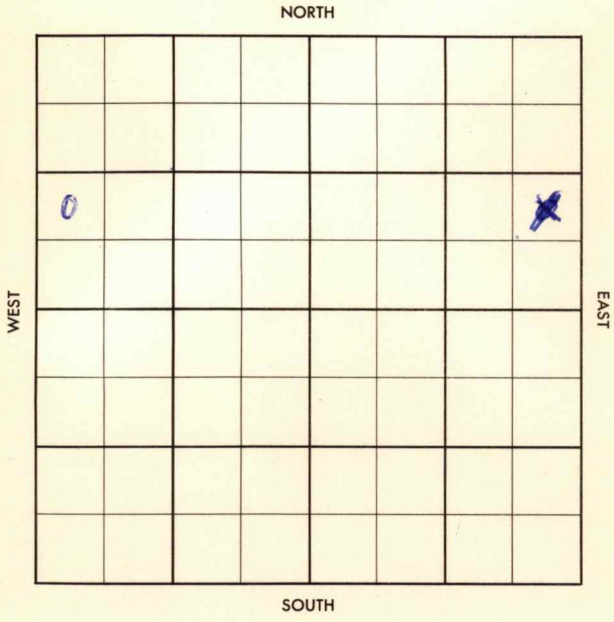

FORM 504-3 SUNRAY

Cowley KANSAS

SEC.	TWP.	R.
15	35	5E

WELL NO.

#1 Warren SWD FARM


COMPANY

W.H. Pitts

CONTRACTOR

Martin

Kanok

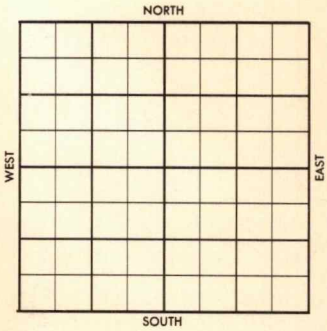

_____ FT. FROM N. LINE

_____ FT. FROM S. LINE

_____ FT. FROM E. LINE

_____ FT. FROM W. LINE

NW SW NW

1956	ELEVATION REPORT
5-23 6-13	RUR Comm. 5-22-56 8 5/8" @ 100 5½" @1945 FB bo S 1865-85 Log: Hoover 1860' TD 1955' SWD Abandoned ABANDONED

FORM 513 SUNRAY

County Cowley Elev.

Sec. 15 Twp. 35 Rge. 5E

Company W. H. Pitts

Farm Name Warren SWD No. 1

TOPS	DEPTH	LOG	DATUM
Anh.			
Tp.			
H.			
Tr.			
Dg. Heeb	1860	1860	
Bl.			
L.			
K.C.			
B.K.C.			
Ce.			
C.			
M.			
M.			
K.			
Mz.			
Mo.			
V.			
S.			
S.			
A			
R.			
P€.			
G.			
TD	1955		

Loc. in Sec. NW SW NW

Geol.

Contr. Martin

Pool Kanok

ABANDONED

JUN 13 '56

Date Comm.

R U R MAY 29 '56 5-22-56 85/8 @

100/ 5½ @ 1954/ JUN 6 '56 JUN 13 '56

DF 80 & 1865-85

Stan D. [illegible]

Co. Lse. No. Sec. T. R.

FORM 513 SUNRAY

County Cowley Elev.

Sec. 15 Twp. 35 Rge. 5E

Company W. H. Pitts

Farm Name Warren SWD No. 1

TOPS	DEPTH	LOG	DATUM
Anh.			
T.P.			
H.			
Tr.			
Dg.			
B.L.			
L.			
K.C.			
B.K.C.			
Ce.			
C.			
M.			
M.			
K.			
Mz.			
Mo.			
V.			
S.			
S.			
A			
R.			
P€.			
G.			
T.D.			

Loc. in Sec. NW SW NW

Geol.

Contr. Martin

Pool Kanok

FIRST REPORT

MAY 23 '56

Date Comm. R U R

Co. Lse. No. Sec. T. R.