
Cowley KANSAS

SECTION 16 TOWNSHIP 35 RANGE 5E

WELL NO. #2 Baird

COMPANY ## W.H. Pitts

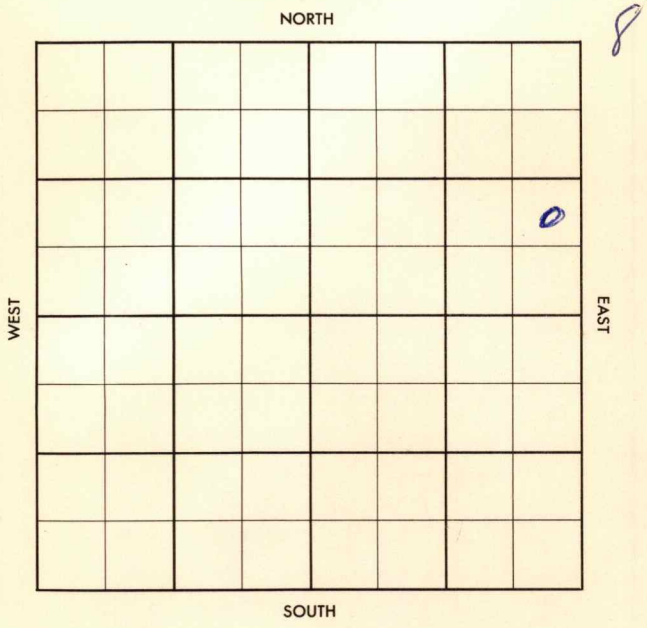

8

Cowley KANSAS

SEC.	TWP.	R.
16	35	5E

WELL NO. #2 Baird FARM

COMPANY W.H. Pitts

CONTRACTOR Martin

Kanok


_____ FT. FROM N. LINE

_____ FT. FROM S. LINE

_____ FT. FROM E. LINE

_____ FT. FROM W. LINE

NE SE NE

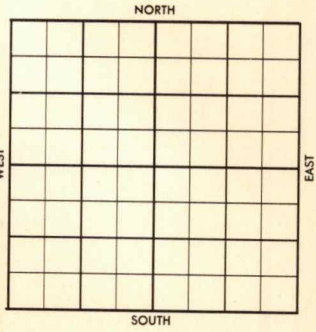

1956	ELEVATION 1225' REPORT
5-23	Comm. 5-7-56 DST 3160-72 op 2 hrs.rec. 95' oil, 300' ocm, 30' wtr., 1045#, 5" @ 3195 Layton 2369', Chbd. 2638', Cleve.2693' Marm. 2757', C. 3143', M. 3160', M. lime 3182', S.SD. 3566', A. 3577' TD 3600'
5-29	Co 24/3162-68 B/ 5 ## goph, no/wtr. Frac S/ 5½ goph, no/wtr. P/ 25 BOPD, no/wtr. TD 3600'

COMPLETED

FORM 504-5 SUNRAY

FORM 513 SUNRAY

County Cowley Elev. 1225

Sec. 16 Twp. 35 Rge. 5E

Company W. H. Pitts

Farm Name Baird No. 2

TOPS	DEPTH	LOG	DATUM
Anh.			
T.P.			
H. Layton	2369		1144
Tr. Chbd.	2638		1413
Dg.			
Bl. Cleve.	2693		1468
L. Marm.	2757		1532
K.C.			
B.K.C.			
Ce.			
C.	3113		1918
M.	3160		1965
M. lime	3182		1987
K.			
Mz.			
Mo.			
V.			
S. sd	3566		2391
S.			
A	3577		2382
R.			
Pe.			
G.			
T.D.	3600		

Loc. in Sec. NE SE NE

Geol.

Contr. Martin

Pool Kanok

COMPLETE

Date Comm. 5-7-56 MAY 29 1956

DST 3160-72 open 2hr. Rec. 95' oil
300' ocm 30' wtr. 1045# 5" @ 3195

MAY 29 '56 CO 24/3162-68 Ø 5 Goph
n/w Frac Ø 5½ Boph n/w
Pot. P. 25 Bopd n/w wtr.

Co. Lse. No. Sec. T. R.

FORM 513 SUNRAY

County Cowley Elev. 1225

Sec. 16 Twp. 35 Rge. 5E

Company W. H. Pitts

Farm Name Baird No. 2

TOPS	DEPTH	LOG	DATUM
Anh.			
T.P.			
H. Layton	2369		
Tr. Chbd.	2638		
Dg.			
B.L. Cleve.	2693		
L.			
K.C. Marm.	2757		
B.K.C.			
Ce.			
C.	3143		
M.	3160		
M. lime	3182		
K.			
Mz.			
Mo.			
V.			
S. sd	3566		
S.			
A	3577		
R.			
P€.			
G.			
T.D.	3600		

Loc. in Sec. NE SE NE

Geol.

Contr. Martin

Pool Kanok

FIRST REPORT

MAY 23 '56

Date Comm. 5-7-56

DST 3160-72 open2hr. Rec. 95' oil
300' ocm 30' wtr. 1045# 5" @ 3195

Co. Lse. No. Sec. T. R.