

Section 29 Township 16 Range 11-W

Well No. 3 Joseph


Company Gulf

prusa pool

NORTH

WEST

EAST

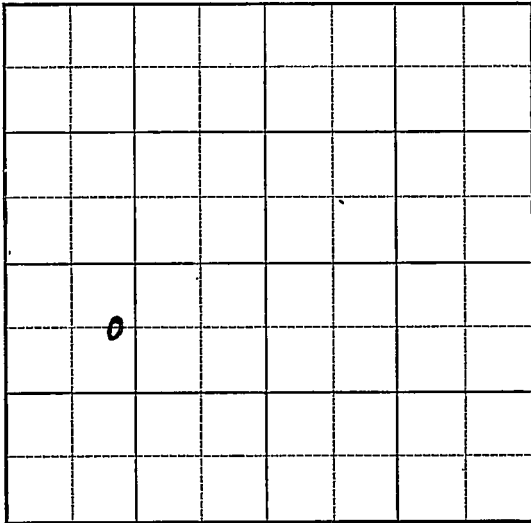

SOUTH

Map No. 55 Sec. 29 Twp. 16 R. 11WWell No. 3 Joseph

Gulf

Company

FIRST REPORT

Contractor

SECTION PLAT

C E L NW SW

660 Ft. from N. Line

_____ Ft. from S. Line

_____ Ft. from E. Line

1050 Ft. from W. Line

o			

PRUSA POOL

Location _____

Rig up _____

Drilling and Remarks:

Pits

RECORD

Cased _____ in., _____ ft.

Sand _____

Gas _____

Oil _____

Total Depth _____

PRODUCTION

1st 24 hrs. Nat. _____

1st 24 hrs. after shot _____

Gas _____ Cu. Ft.

Dry Hole _____

Abandoned _____

Date

AUG 20 1941₁₉S. J. LEWIS Scout

Map No. _____ Sec. 29 Twp. 16 R. 11WWell No. 3 JosephGulf Company~~COMPLETED~~ Contractor

C E L NW SW

SECTION PLAT

660 Ft. from N. Line

_____ Ft. from S. Line

_____ Ft. from E. Line

1050 Ft. from W. Line

PRUSA POOL

Location _____

Rig up _____

Drilling and Remarks:

*Go to kam 3314**7" @ 3314**Pump 50 Pst**71'**43' @ 3314*

RECORD

Cased _____ in., _____ ft.

Sand _____

Gas _____

Oil _____

Total Depth 3323

PRODUCTION

1st 24 hrs. Nat. _____

1st 24 hrs. after shot _____

Gas _____ Cu. Ft.

Dry Hole _____

Abandoned _____

Date

SEP 17 1941

19

S. J. LEWIS

Scout