


Cowley

KANSAS

SECTION 15 TOWNSHIP 35 RANGE 5E

WELL NO. #2 Warren "A"

COMPANY W.H. Pitts

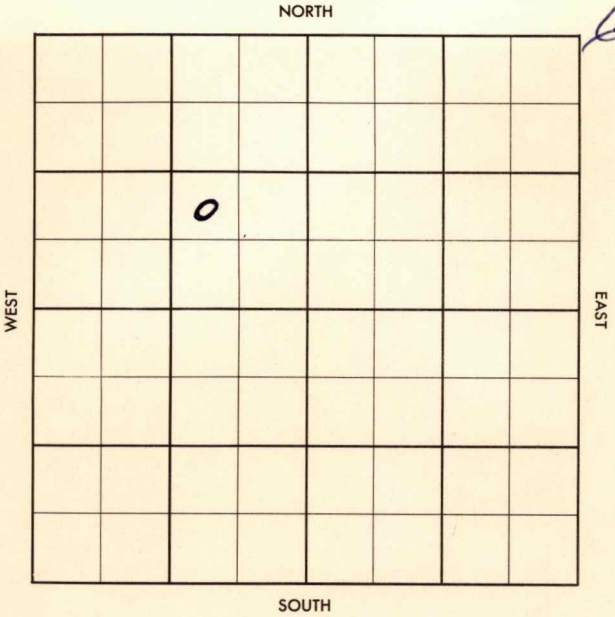

Cowley

KANSAS

SEC.

15

TWP.

35

R.

5E

WELL NO.

#2 Warren "A"

FARM

COMPANY

W. H. Pitts

CONTRACTOR

Martin Tools


Kanok

\_\_\_\_\_ FT. FROM N. LINE

\_\_\_\_\_ FT. FROM S. LINE

\_\_\_\_\_ FT. FROM E. LINE

\_\_\_\_\_ FT. FROM W. LINE

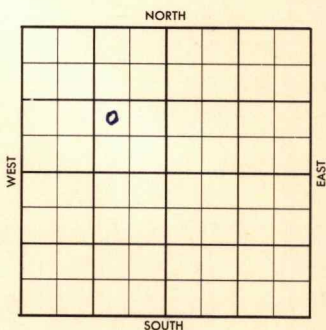

NW SE NW (Twin)

ELEVATION

1956

REPORT

9-12

Loc

Co.

County Cowley Elev. 1258  
 Sec. 15 Twp. 35 Rge. 5E  
 Company W. H. Pitts  
 Farm Name Warren "A" No. 2

| TOPS   | DEPTH               | LOG | DATUM | Loc. in Sec. |
|--------|---------------------|-----|-------|--------------|
| Anh.   |                     |     |       | NW SE NW     |
| TP.    |                     |     |       |              |
| H.     |                     |     |       | Twin         |
| Tr.    |                     |     |       |              |
| Dg.    |                     |     |       |              |
| BL.    |                     |     |       |              |
| L.     |                     |     |       | Geol.        |
| K.C.   |                     |     |       |              |
| B.K.C. |                     |     |       | Contr.       |
| Ce.    |                     |     |       |              |
| C.     |                     |     |       | Martin Tools |
| M.     | <u>chat 3175</u>    |     |       |              |
| M.     | <u>ca 3173</u>      |     |       | Pool         |
| K.     | <u>M. chat 3187</u> |     |       | Kanok        |
| Mz.    |                     |     |       |              |
| Me.    |                     |     |       |              |
| V.     |                     |     |       |              |
| S.     |                     |     |       |              |
| S.     |                     |     |       |              |
| A.     |                     |     |       |              |
| R.     |                     |     |       |              |
| PE.    |                     |     |       |              |
| G.     |                     |     |       |              |
| TD.    | <u>3189</u>         |     |       |              |

Lse.

No.

Sec.

T.

R

Date Comm.

SEP 19 '56

9-10-56 858

60 5 1/2 @ 3188 SEP 26 '56 CO DD

3197 Frac. <sup>screened out</sup> CO OCT 3 '56P. 15 Bopd + 35 BWpd CO  
to Re Frac. OCT 19 '56 POP OCT 17 '56

P. 20 BWph OCT 24 '56 P. OCT 31 '56

P wtr. NOV 7 '56 ✓ NOV 13 '56 ✓ NOV 21 '56

P 4 1/2 Bo + 480 BW 24 hrs.

County Cowley

Elev. \_\_\_\_\_

Sec. 15Twp. 35Rge. 5ECompany W. H. PittsFarm Name Warren "a"No. 2

TOPS

DEPTH

LOG

DATUM

Loc. in Sec. \_\_\_\_\_

Anh. \_\_\_\_\_

Tp. \_\_\_\_\_

H. \_\_\_\_\_

Tr. \_\_\_\_\_

Dg. \_\_\_\_\_

Bl. \_\_\_\_\_

L. \_\_\_\_\_

K.C. \_\_\_\_\_

B.K.C. \_\_\_\_\_

Ce. \_\_\_\_\_

C. \_\_\_\_\_

M. \_\_\_\_\_

M. \_\_\_\_\_

K. \_\_\_\_\_

Mz. \_\_\_\_\_

Mq. \_\_\_\_\_

V. \_\_\_\_\_

S. \_\_\_\_\_

S. \_\_\_\_\_

A. \_\_\_\_\_

R. \_\_\_\_\_

Pc. \_\_\_\_\_

G. \_\_\_\_\_

\_\_\_\_\_

T.D. \_\_\_\_\_

NW SE NW

Twin

Geol. \_\_\_\_\_

Contr. \_\_\_\_\_

Martin Tools

Pool

Kanok

FIRST REPORT

SEP 13 '56

Date Comm. \_\_\_\_\_

2/9

SEP 13 '56

SEP 13 '56