FORM 51

Barton KANSAS

Section 29 Township 16 Range 11 W

Well No. # 9 Esfeld

Company Derby Oil

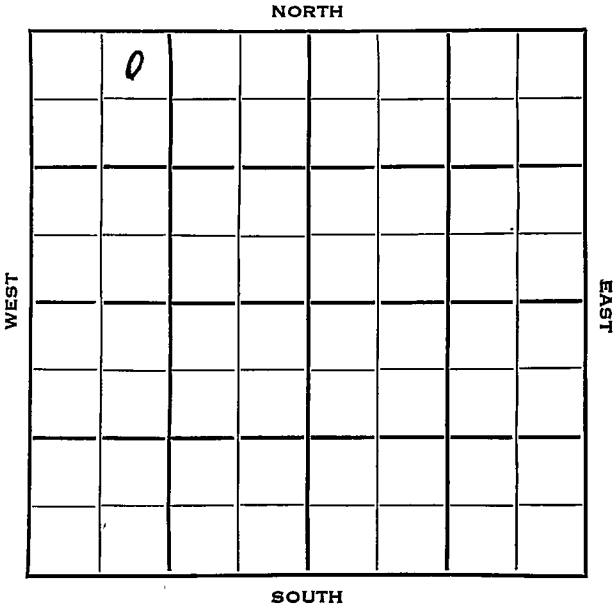

FORM 252-B
10M 8-51 TPCO.

Barton KANSAS

Sec. 29 Twp. 16 R. 11W

Well No. #9 Esfeld Farm

Derby Oil Company

Peel Bros. Contractor
K-P Peel

330 Ft. from N. Line

Ft. from S. Line

Ft. from E. Line

990 Ft. from W. Line

NE NW NW

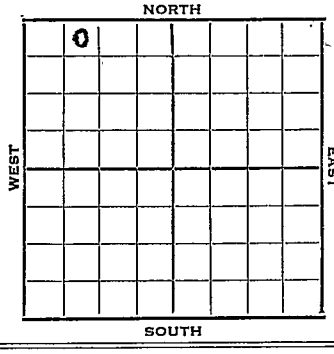

1953	Elev. 1896' REPORT
7/14	Spud 7-10-53 8" @ 562 w/300 Drlg. 1950'
7/22	Heeb 2947 DST 2992-3000', 1/2 hrs., 1580' gas, 35' hvly ocm, 110' mco, 10' w, 1020# Br li 3043, Lans 3064 TD 3380 5" @ 3070'
7/29	30/2992-97, 23 gw 1st hr., 20 go 5th hr., Packer 2960 sd-frac S/12 bfph 10% w 3 hrs.
8/5	No report
8/12	"
8/19	"
8/26	Spud 7-10-53 Oil well TD 3380 8" @ 562 Heeb 2947 DST 2992-3000 open ½ hr rec 1580' gas 35' HO & GCM, 110' MCO, 10' wtr. 1020# Br. lime 3043 Lans 3064 TD 3380 5" @ 3070 Doug 2992 30/2992-97 23 GW 1 hr. 20 GO 5th hr.

OVER

1953
8/26 (Information continued)
SP 2960 Sd-frac. S/12 BFPH
10% wtr. 3 hr. P/139 BO 18 hr.
Comp. 163 BOPD

COMPLETED

FORM 275 FOR SALE BY KANSAS BLUE PRINT CO.

County Barton State Kansas

Sec. 29 (Blk. Twp.) 16 (Sur. Rge.) 11W Map No.

Operator Derby Oil

Well No. 9 Farm Esfeld

Elev. Location NE NW NW

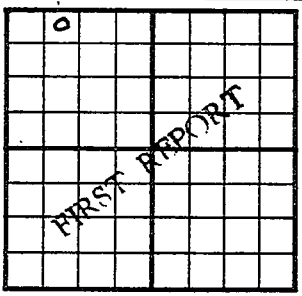

330 Ft. From N Line NW

990 Ft. From W Line Quarter

1st. Report JUL 14 1953

Completion

Remarks Peel Bros-Contr.

Spudding Date 7-10-53

Drlg. Data K-P Pool

8" @ 562 w/300 Drlg. 1950

J. G. McGEHEE

FORM 275 FOR SALE BY KANSAS BLUE PRINT CO.

County Barton State Kansas

Sec. 29 (Blk. Twp.) 16 (Sur. Rge.) 11W Map No.

Operator Derby Oil

Well No. 9 Farm Esfeld

Elev. 1896 Location NE NW NW

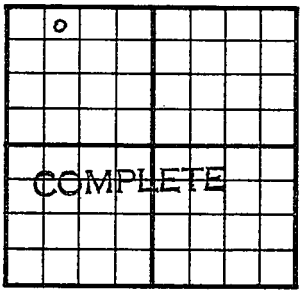

330 Ft. From N Line NW

990 Ft. From W Line Quarter

1st. Report

Completion AUG 26 1953

Remarks K-P Pool

Peel Bros. - Contr.

Spudding Date 7-10-53

Drlg. Data Oil well TD 3380

8" @ 562 Heeb. 2947 DST 2992-3000

open ½ hr. Rec. 1580' gas 35' ho & gcm

110' mco 10' wtr. 1020# Br. lime 3043

Lans. 3064 TD 3380 5" @ 3070

Doug. 2992 30/ 2992-97 23 gw 1 hr.

20 go 5th hr. SP 2960 sd-frac

S/ 12 bfph 10% wtr. 3 hr.

P/ 139 bo 18 hr. Comp. 163 bopd

J. G. McGEHEE