


Section 29 Township 16 Range 11W

Well No. #4 Joseph

Company Gulf

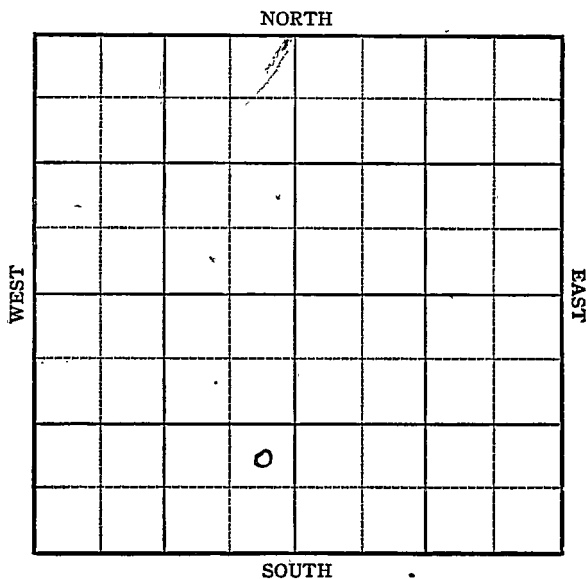


Sec. 29 Twp. 16 R. 11-W

Well No. #4 Joseph Farm

Gulf Company

 Ft. from N. Line
 990 Ft. from S. Line
 330 Ft. from E. Line
 Ft. from W. Line

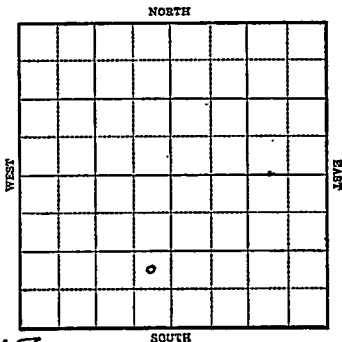

Elev. 1917

1944

R E P O R T

1-26 Surface Hole
 2/2 8" @ 326
 Drlg. 2772
 2/8 Lans 3076
 Arb 3337
 SO 3337-40 TD
 5" @ 3338
 Rust
 2/15 "
 2/3 TD 3347
 2000 acid
 Pump 21 oil per hr.
 3/1 5" @ 3338
 Arb 3337
 TD 3347
 5" @ 3338
 2000 acid
 Echo Pot. 672
 Gravity 42.3

COMPLETED

KANSAS

Map No. 2 Sec. 29 Twp. 16 R. 11WWell No. 4 Joseph

Gulf

Company

FIRST REPORT

Contractor

NE SE SW

SECTION PLAT

	o		

_____ Ft. from N. Line

990 Ft. from S. Line330 Ft. from E. Line

_____ Ft. from W. Line

Kraft Prusa Pool

Location _____

Rig up _____

Drilling and Remarks:

Surface Hole

RECORD

Cased _____ in., _____ ft.

Sand _____

Gas _____

Oil _____

Total Depth _____

PRODUCTION

1st 24 hrs. Nat. _____

1st 24 hrs. after shot _____

Gas _____ Cu. Ft.

Dry Hole _____

Abandoned _____

Date

JAN 26 1944 19

S. J. LEWIS Scout

