


Section 29 Township 16 Range 11WWell No. #7 JosephCompany Gulf Oil

NORTH

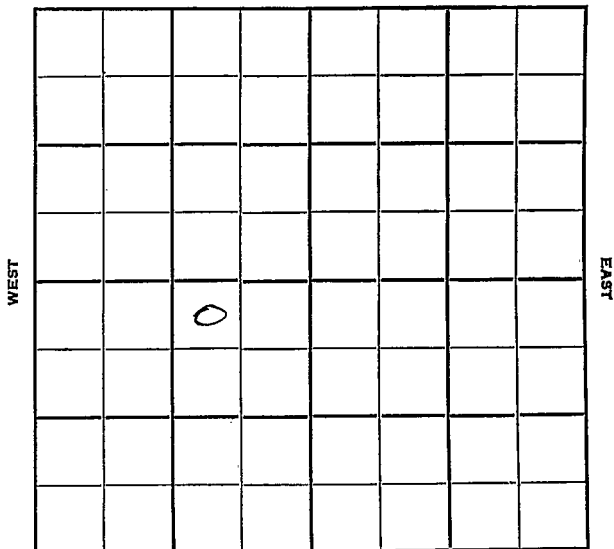

SOUTH

Barton

KANSAS

Sec. 29 Twp. 16 R. 11W

Well No. #7 Joseph Farm

Gulf Oil Company

Herndon Drlg. Contractor

Kraft-Prusa Pool


330' Ft. from N. Line

 Ft. from S. Line

990' Ft. from E. Line

 Ft. from W. Line

NW NE SW

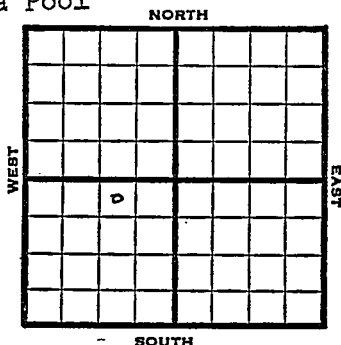

1951

Elev. 1892' REPORT

2/6

Location

3/21

Spud 2-6-51

Oil Well TD 3320

8" @ 746

Heeb. 2929'

Br Line 3029

Lans. 3047

DST 3123-30 opn 1hr

Rec. 105' wcm SS0

Arb. 3316-20 SO

5" @ 3317 TD 3320

B/13 bo 500 A

S/6 boph Comp. 79 bopd

COMPLETED

County **Barton** State **Kansas**

Sec. 29 (Blk.) 16 (Sur.) 11W Map No.

Operator **Gulf Oil**

Well No. 7 Farm Joseph

Elev.	Location	NW	NE	SW
-------	----------	----	----	----

FIRST REPORT

330 Ft. From N Line SW

990 Ft. From F Line Quarter

1st. Report **FEB 7 1954**

Completion

Remarks


Herndon Drlg. & Contr.

Spudding Date

Drlq. Data Kraft-Prusa Pool

Location	%
1. ...	...
2. ...	...
J. E. TYRA

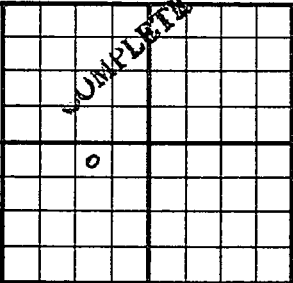County	Barton		State	Kansas	
Sec.	29	(Blk.) (Twp.) 16	(Sur.) (Rge.) 11W	Map No.	
Operator	Gulf Oil				
Well No.	7	Farm	Joseph		
Elev.	1892	Location	NW NE SW		
			330 Ft. From	N Line	SW
			990 Ft. From	E Line	Quarter
			1st. Report		
			Completion	MAR 21 1957	
			Remarks	Kraft-Prusa Pool	
			Herndon Drlg. - Contr.		
Spudding Date			2-6-51		

Drlg. Data Oil well TD 3320
 8" @ 746 Heeb. 2929 Br. lime 3029
 Lans. 3047 DST 3123-30 open 1 hr.
 Rec. 105' wcm SSO Arb. 3316-20 SO
 5" @ 3317 TD 3320 B/ 13 bo 500 A
 S/ 6 boph Comp. 79 bopd

J. E. TYRA