

KANSAS


Barton

FORM 51 5M PETROL

Section 29 Township 16 Range 11W

Well No. 6 Joseph

Company Gulf

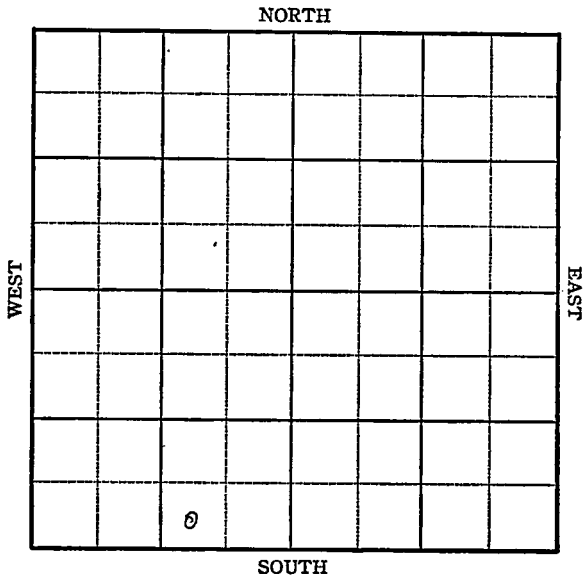

Sec. 29 Twp. 16 R. 11-W

Well No. #6 Joseph Farm


Gulf Company

         Ft. from N. Line

330 Ft. from S. Line

990 Ft. from E. Line

         Ft. from W. Line

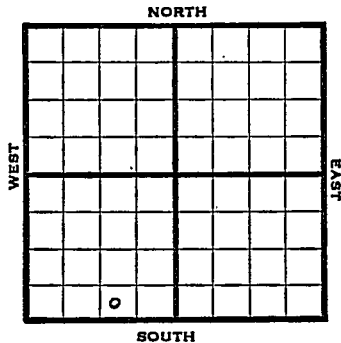

SW SE SW

1945 Elev. 1918 REPORT

11/21 Location

11/28 8" @ 557 WOC

12/5 Drlg. 2605'

12/12 Lans 3069

Arb. 3350.

TD 3354

5" @ 3351 RUST

12/20 600' oil in 5 hours.

12/29 T.D. 3358' 1550' oil 5 hours.  
1000 acid. Pump 66 oil in 8 hours.

1946

1/10 " "

1/17 " "

1/24 " "

1/30 Lans 3069  
Arb. 3350  
5" @ 3351  
1000 acid.  
TD 3385'  
Pump 230 Pot.  
Grav. 40.6

COMPLETED

**KANSAS**

Kansas

Pool Name

Kraft-Prusa

Map No. 55 Sec. 29 Twp. 16 R. 11W

Well No. 6 Joseph

Gulf

Company

**FIRST REPORT**

Contractor

SW SE SW

**SECTION PLAT**


           Ft. from N. Line

330 Ft. from S. Line

990 Ft. from E. Line

           Ft. from W. Line

Barton County

Location            X

Rig up           

Drilling and Remarks:

**RECORD**

Cased            in.,            ft.

Sand           

Gas           

Oil           

Total Depth           

**PRODUCTION**

1st 24 hrs. Nat.           

1st 24 hrs. after shot           

Gas            Cu. Ft.

Dry Hole           

Abandoned           

Date

NOV 21 1915 19

S. J. LEWIS

Scout

.. **KANSAS** Kansas Pool Name Kraft-Prusa Pool

Map No. 55 Sec. 29 Twp. 16 R. 11W

Well No. 6 Joseph

Gulf Company

~~COMPLETED~~

Contractor

*E. J. Lewis*

SW SE SW

SECTION PLAT

\_\_\_\_\_ Ft. from N. Line

330 Ft. from S. Line

990 Ft. from E. Line

\_\_\_\_\_ Ft. from W. Line


Barton County

Location \_\_\_\_\_

Rig up \_\_\_\_\_

Drilling and Remarks:

*Acid 3069*  
*Cr 73880*  
*5" 33851*  
*100 acid*  
*Pump 230 ft*  
*4 1/2 9 1/2*

**RECORD**

Cased \_\_\_\_\_ in., \_\_\_\_\_ ft.

Sand \_\_\_\_\_

Gas \_\_\_\_\_

Oil \_\_\_\_\_

Total Depth 3385

**PRODUCTION**

1st 24 hrs. Nat. \_\_\_\_\_

1st 24 hrs. after shot \_\_\_\_\_

Gas \_\_\_\_\_ Cu. Ft.

Dry Hole \_\_\_\_\_

Abandoned \_\_\_\_\_

Date

JAN 30 1946

19

S. J. LEWIS

Scout