Barton

KANSAS

29 . 16 11W

SECTION TOWNSHIP RANGE

WELL NO. #11 Joseph

COMPANY Gulf Oil Corp.

NE NE SW

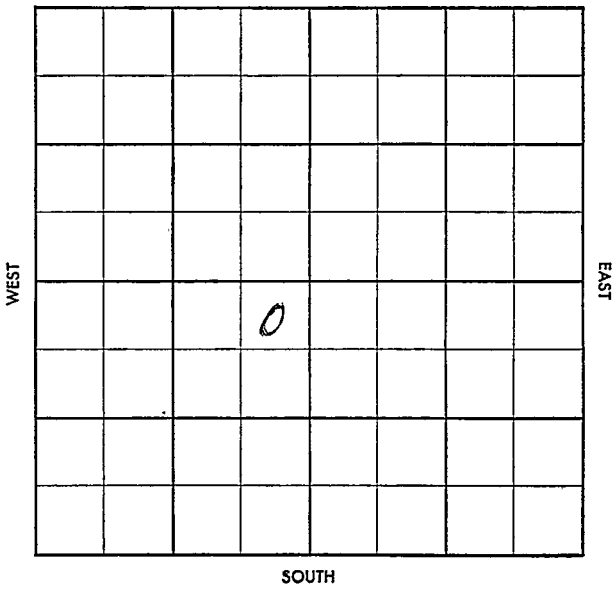

FORM 504-3 SUNRAY

S-513-A

CO. Barton ELEV. ____

SEC. 29 TWP. 16 RGE. 11W

COMPANY Gulf Oil Corp NO. 11

FARM Joseph

LOC. NE NE SW

GEOL. ____

CONTR. ____

POOL Kraft

SPUD ____

Location

FIRST REPORT

0

OCT 9 '57

E.O.

LSE.

NO.

SEC.

TWP.

RGE.

S-513-A

CO. Barton ELEV. 1910DF

SEC. 29 TWP. 16 RGE. 11W

COMPANY Gulf Oil Corp NO. 11

FARM Joseph

LOC. NE NE SW

COMPLETE
0
NOV 20 '57

CO.

LSE.

NO.

SEC.

TWP.

RGE.

A 758	
Kow 2619	
TP 2697	
Hb 2946	
TR 2964	
Dq sh 2975	
Dq sd 2993	
BJ 3043	
L 3062	
TD 3090	

GEOL.

CONTR.

POOL Kraft

SPUD 10-16-57

Location

OCT 28 '57 8" 767/375

D 3036 OCT 31 '57

Log Tops Hb 2948
TR 2964 Dq sh 2976
Dq sd 2998 BL 3041
Lkc 3064 5½ 3082/75
CO 46/2996-3008 250A
frac 5 x 5 sd on Ld NOV 6 '57 POP
to rec Ld P 48 BO + 40 BW
24 hrs. NOV 21 '57 P 2,17 BO
+ 6.33 BW

8.68 BO Pd + 25 32 W
Dq 2996-3008