

Section 32 Township 17 Range 14-W

Well No. #1 Manneth

Company G-M-R Oil

NORTH

							0

16

WEST

EAST

SOUTH

Barton

Sec. 32 Twp. 17 R. 14W

Well No. #1 Menneth Farm

G-M-R Oil Company

Lohman & Johnson - Contr. Contractor

Boyd Pool

_____ Ft. from N. Line

330'


_____ Ft. from S. Line

330'

_____ Ft. from E. Line

_____ Ft. from W. Line

SE SE SE

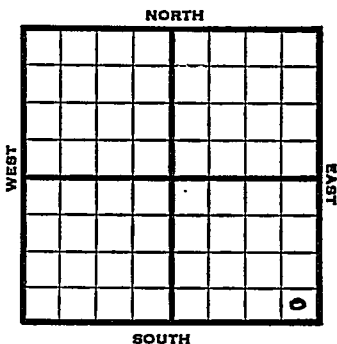

1951

Elev. 1947' REPORT

1/10

RUR

2/21

Spud 1-9-51

Oil well TD 3450

8" @945

Heeb. 3125 Lans. 3190 Sat. 3215-22

DST 3192-3222 open 45 min. rec. 195'

water Cong. 3421 Arb. 3447

DST 3447-50 open 20 min. rec. 155' oil

20' water

5" @3447

TD 3450

P/ 2 1/2 boph

Comp. 55 bopd 36 gr.

COMPLETED

