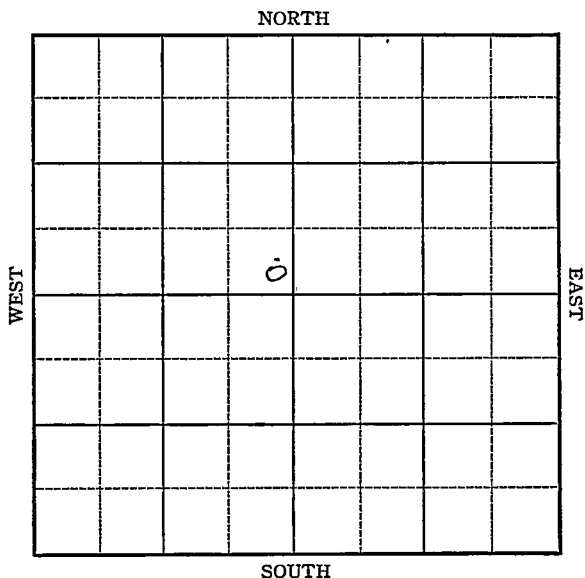


Section 33 Township 17 Range 14-WWell No. #1 HickeyCompany Phillips

KANSAS

Barton

Sec. 33 Twp. 17 R. 14-W

Well No. #1 Hicley Farm

Phillips Company


Wildcat

 Ft. from N. Line

330 Ft. from S. Line

330 Ft. from E. Line

 Ft. from W. Line

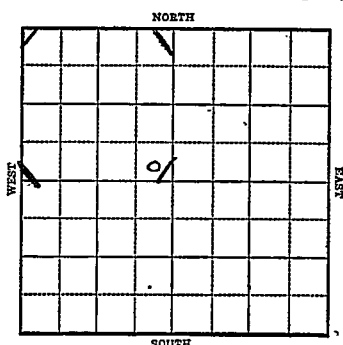

Sec. 1899

1943

R E P O R T

4/7

8" @ 627'

Drlg. 1900'

4/14

Topeka 2849

Lans 3165

Congl 3375

Drlg. 3388'

4/21

Arb 3394

5" @ 3399

T.D. 3402: SO RUSSE

4/28

T.D. 3403-5 qts 3399-3403 very

SSO & W

5/5

T.D. 3430 fsg.

5/12

SD

5/19

"

5/26

Arb. 3394

5" @ 3399'

T.D. 3436'

Water.


ABANDONED

Barton KANSAS

Map No. 73 Sec. 33 Twp. 17 R. 14WWell No. 1 HickeyPhillips CompanyFIRST REPORT Contractor

SE NW

SECTION PLAT

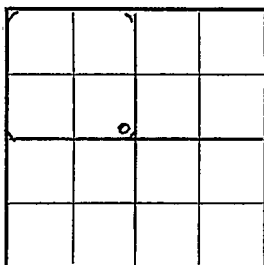 Ft. from N. Line330 Ft. from S. Line330 Ft. from E. Line Ft. from W. Line

WILDCAT

Location Rig up

Drilling and Remarks:

8"-627'

Dr1g. 1900'

RECORD

Cased in., ft.Sand Gas Oil Total Depth

PRODUCTION

1st 24 hrs. Nat. 1st 24 hrs. after shot Gas Cu. Ft.Dry Hole Abandoned

Date

APR 7 1943 19

S. J. LEWIS Scout

Barton

KANSAS

Map No. 72 Sec. 33 Twp. 17 R. 14WWell No. 1 HickeyPhillips


Company

ABANDONED

Contractor

SE NW

SECTION PLAT

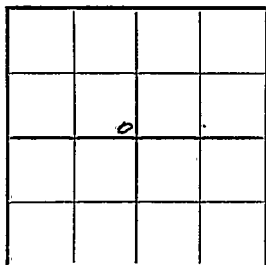 Ft. from N. Line330 Ft. from S. Line330 Ft. from E. Line Ft. from W. Line

WILDCAT

Location Rig up

Drilling and Remarks:

*Ar 3394**5' @ 3399**Water.*

RECORD

Cased in., ft.Sand Gas Oil Total Depth 3436

PRODUCTION

1st 24 hrs. Nat. 1st 24 hrs. after shot Gas Cu. Ft.Dry Hole Abandoned

Date

MAY 26 1943 19S. J. LEWIS

Scout