
FORM 51 25M 8-50 WESTERN

Barton KANSAS

Section 29 Township 16 Range 11W

Well No. #4 Wendtlandt

Company N. C. R. A.

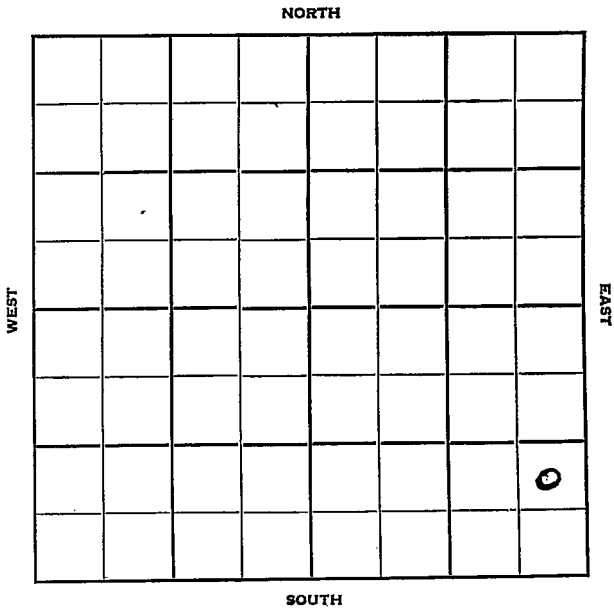

FORM 252-B
10M 10-50 PETROL

Barton KANSAS

Sec. 29 Twp. 16 R. 11 W ✓

Well No. #4 Wendtlandt Farm

NCRA Company

Anschultz
~~Graft~~-Prusa Contractor


____ Ft. from N. Line

990 Ft. from S. Line

330 Ft. from E. Line

____ Ft. from W. Line

NE SE SE

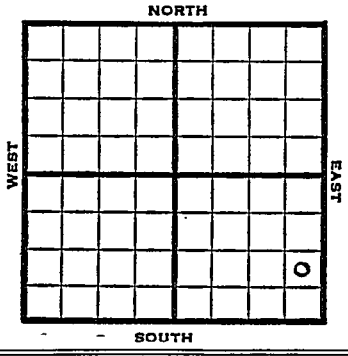

1952	Elev. 1915' REPORT
1/9	RUR
2/6	Spūd 1-7-52 D&A TD 3369 8" @ 287 Anhy 775 Heeb. 2961 Br. Li 3057 Lans. 3079 Arb. 3349 DST 3350-52 open 2 hr. rec. 25' mud 5" @ 3350 DD 3361 500 A B/ 13 go 23 gw 1 hr. DD 3369 wtr. D&A

ABANDONED

FORM 275 FOR SALE BY KANSAS BLUE PRINT CO.


County Barton State Kansas

Sec. 29 (Blk. Twp.) 16 (Sur. Rge.) 11W Map No.

Operator N. C. R. A.

Well No. 4 Farm Wendtlandt

Elev. Location NE SE SE

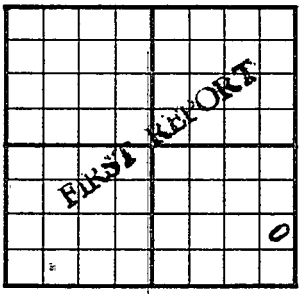

990 Ft. From S Line SE

330 Ft. From E Line Quarter

1st. Report JAN 9 1952

Completion

Remarks

Anchultz - Contr.

Spudding Date

Drlg. Data Kraft Prusa

RUR

J. E. TYRA

FORM 275 FOR SALE BY KANSAS BLUE PRINT CO.


County Barton State Kansas

Sec. 29 (Blk. Twp.) 16 (Sur. Rge.) 11W Map No.

Operator N C R A

Well No. 4 Farm Wendtlandt

Elev. 1915 Location NE SE SE

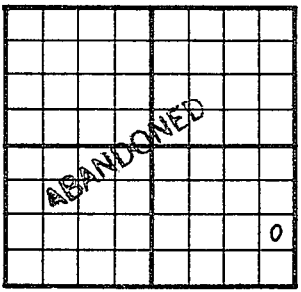

990 Ft. From S Line SE

330 Ft. From E Line Quarter

1st. Report

Completion FEB 6 1952

Remarks Kraft-Prusa Pool

Anschutz - Contr.

Spudding Date 1-7-52

Drlg. Data D & A TD 3369

8" @ 287 Anhy 775 Heeb. 2961

Br. lime 3057 Lans. 3079 Arb. 3349

DST 3350-52 open 2 hr. Rec. 25' mud

5" @ 3350 DD 3361 500 A B/ 13 go

23 gw 1 hr. DD 3369 water

D & A

J. G. McGEHEE