

Barton

KANSAS

1


17

15W

SECTION _____ TOWNSHIP _____ RANGE _____

WELL NO. #1 First Methodist Church

COMPANY Birmingham-Bartlett

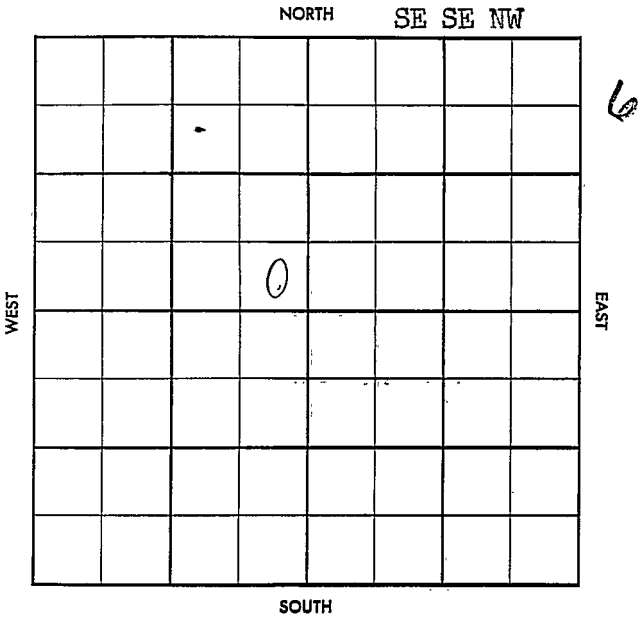

TOPS	DEPTH	LOG	DATUM
Anh.			
Tp.			
H.			
Tr.			
Dg.			
Bl.			
L.			
K.C.			
B.K.G.			
Ce.			
C.			
M.			
M.			
K.			
Mz.			
Mq.			
V.			
S.			
S.			
A.			
R.			
P.E.			
G.			
F.D.			

Loc. in Sec.
SE SE NW

 Geol. _____
 Contr. _____
 Co. Tools
 Pool
Leoville
FIRST REPORT
 o
FEB 27 '57

Date Comm. 2-22-57
8" @ 984 Drlg. 2610

15

County BartonElev. 1976Sec. 1Twp. 17Rgs. 15WCompany Birmingham-BartlettFarm Name First Methodist Church No. 1

TOPS	DEPTH	LOG	DATUM	Loc. in Sec.
Anh.	974			SE SE NW
Tr.				
H.	3153			
Tr.	3170			
Dg.				
Bl.	3217			
L.	3234			
K.C.				Geol.
B.K.C.				Contr.
Ce.				Co. Tools
C.				
M.				Pool
M.				Leoville
K.				
Mz.				
Me.				
V.				
S.				COMPLETE
S.				
A	3460			
R.				
Pe.				
G.				
T.D.	3463			MAP 13 57

Date Comm. 2-22-578" @ 984 Drlg. 2610 11 L 57 DST3228-41 40" 2300' SWBHP 1195 5 1/2 @ 3461 MICTCo MAP 13 57 Co 3463 FU 1000' / 1 hrPO 3464 FU 2600' / 10 hrs NWPOPP.P 180 BOPD