

# KANSAS


Barton

FORM 51 5M 10-41 PETROL

Section 30 Township 16 Range 11-W

Well No. #7 Esfeld

Company Skelly

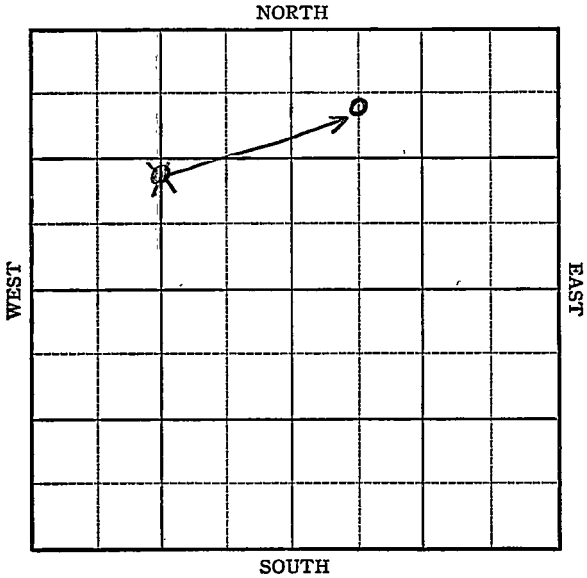

Sec. 30 Twp. 16 R. 11-W

Well No. #7 Esfeld Farm

Skelly Company


(Kraft Prusa)

~~1470~~ <sup>810</sup> Ft. from N. Line

\_\_\_\_\_ Ft. from S. Line

\_\_\_\_\_ Ft. from E. Line

<sup>660</sup>  
~~1320~~ Ft. from W. Line

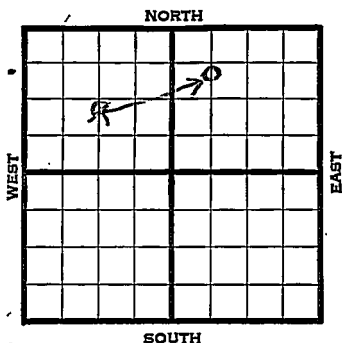

Elev. 1904

1942	REPORT
5/6	Location
5/13	Derrick.
5/20	8" - 353' WOC.
5/27	Drlg. 2740'
6/3	Lans. 3020' S.O. 3039-42, & 3065-69'
	Granite 3287-88' T.D. 5" - 3287' RUST
6/10	Drilled plug to 3247'
	59 shots 3062-74' 47 shots 3035-45'
	9000 acid. Flow 75 oil in 6 hours.
6/17	Lans. 3020'
	Granite 3287'
	5" - 3287'
	T.D. 3288'
	106 shots 3035-74'
	9000 acid.
	Bomb potential 1986 bbls.
	40. Gravity
	<b>COMPLETED</b>

Barton **KANSAS**

Map No. 55 Sec. 30 Twp. 16 R. 11W

Well No. 7 Esfeld

Skelly Company

**FIRST REPORT**

Contractor

C NL S  $\frac{1}{2}$  NW

1470 Ft. from N. Line

\_\_\_\_\_ Ft. from S. Line

\_\_\_\_\_ Ft. from E. Line

1320 Ft. from W. Line

**SECTION PLAT**

	o		

**KRAFT PRUSA POOL**

Location XX

Rig up \_\_\_\_\_

Drilling and Remarks:

**RECORD**

Cased \_\_\_\_\_ in., \_\_\_\_\_ ft.

Sand \_\_\_\_\_

Gas \_\_\_\_\_

Oil \_\_\_\_\_

Total Depth \_\_\_\_\_

**PRODUCTION**

1st 24 hrs. Nat. \_\_\_\_\_

1st 24 hrs. after shot \_\_\_\_\_

Gas \_\_\_\_\_ Cu. Ft.

Dry Hole \_\_\_\_\_

Abandoned \_\_\_\_\_

Date

MAY 6 1942

S. J. LEWIS Scout

KANSAS

Map No. 55 Sec. 30 Twp. 16 R. 11W

Barton

Well No. 7 Esfeld

Skelly

Company

CORRECTION

Contractor

C NW NE

## SECTION PLAT

810 Ft. from N. Line

		o	

\_\_\_\_\_ Ft. from S. Line

\_\_\_\_\_ Ft. from E. Line

660 Ft. from W. Line

## KRAFT PRUSA POOL

## RECORD

Location \_\_\_\_\_

Cased \_\_\_\_\_ in., \_\_\_\_\_ ft.

Rig up \_\_\_\_\_

Sand \_\_\_\_\_

Drilling and Remarks:

Gas \_\_\_\_\_

Oil \_\_\_\_\_

Reported

Total Depth \_\_\_\_\_

C NL S $\frac{1}{2}$  NW

## PRODUCTION

1st 24 hrs. Nat. \_\_\_\_\_

1st 24 hrs. after shot \_\_\_\_\_

Gas \_\_\_\_\_ Cu. Ft.

Dry Hole \_\_\_\_\_

Abandoned \_\_\_\_\_

35

Date

MAY 13 1942 19

S. J. LEWIS Scout

Barton

KANSAS

Map No. 55 Sec. 30 Twp. 16 R. 11W

Well No. 7 Esfeld

Skelly Company

**COMPLETED** Contractor

C NW NE

SECTION PLAT

810 Ft. from N. Line

		a	

\_\_\_\_\_ Ft. from S. Line

\_\_\_\_\_ Ft. from E. Line

660 Ft. from W. Line

KRAFT PRUSA POOL

Location \_\_\_\_\_

RECORD

Rig up \_\_\_\_\_

Cased \_\_\_\_\_ in., \_\_\_\_\_ ft.

Drilling and Remarks:

Sand \_\_\_\_\_

Gas \_\_\_\_\_

Oil \_\_\_\_\_

Total Depth 3288

PRODUCTION

1st 24 hrs. Nat. \_\_\_\_\_

1st 24 hrs. after shot \_\_\_\_\_

Gas \_\_\_\_\_ Cu. Ft.

Dry Hole \_\_\_\_\_

Abandoned \_\_\_\_\_

*Leane 3020*  
*Granite 3287*  
*5" @ 3287*  
*106 x hole 3035-74*  
*9000 acid*  
*Bond & Bond 1986*  
*4000*

Date

JUN 17 1942 19

S. J. LEWIS Scout