

KANSAS


Barton

FORM 51 5M PETROL

Section 30 Township 16 Range 11W

Well No. 8 Esfeld


Company Skelly

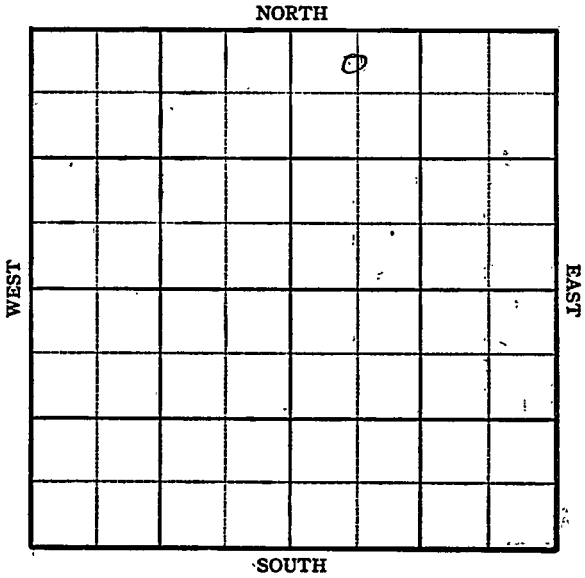

Sec. 30 Twp. 16 R. 11-W

Well No. #8 Esfeld Farm _____
Skelly Company _____

330 Ft. from N. Line
_____ Ft. from S. Line
_____ Ft. from E. Line
660 Ft. from W. Line

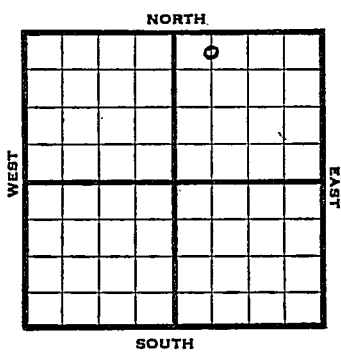

C N L NW NE

REPORT

1945	Elev. 1907
11/7	Location
11/14	8" @ 345. Drlg. 1400'
11/21	Drlg. 3085'
11/28	Topeka 2883 Lans. 3053 Regan 3312 TD 3319
12/5	5" @ 3313 RUST TD 3323 2000 acid. 20 qts. 3312-3322 CO
12/12	Plug 3237 24 shots 3191-3198 500 acid. CO
12/19	Reagan 3312 5" @ 3313 Lans 3053 PB Lans Perf. 4000 acid. TD 3323 Pump 48Rot. Grav. 42.0

COMPLETED

KANSAS Pool Name Kraft-rusa

Map No. 55 Sec. 30 Twp. 16- R. 11W

Well No. 8 Esfeld

Skelly Company

FIRST REPORT Contractor

C N L NW NE

SECTION PLAT

330 Ft. from N. Line

_____ Ft. from S. Line

_____ Ft. from E. Line

660 Ft. from W. Line

		o	

Barton County

Location X

Rig up _____

Drilling and Remarks:

RECORD

Cased _____ in. _____ ft.

Sand _____

Gas _____

Oil _____

Total Depth _____

PRODUCTION

1st 24 hrs. Nat. _____

1st 24 hrs. after shot _____

Gas _____ Cu. Ft.

Dry Hole _____

Abandoned _____

Date

NOV 7 1945 19

S. J. LEWIS Scout

KANSAS Kansas Pool Name Kraft-IrusaMap No. 11-55 Sec. 30 Twp. 16 R. 11WWell No. 8 EsfeldSkelly Company**COMPLETED**

Contractor

C N L NW NE

E 1, 1967
SECTION PLAT330 Ft. from N. Line Ft. from S. Line Ft. from E. Line660 Ft. from W. Line

		6	

Barton County

Location _____

Rig up _____

Drilling and Remarks:

*Keagan 3312**5" 3313**Lans 3058**PB Lans Ref.**4000 acil**June 48 PJ**42 e 8e*

RECORD

Cased _____ in., _____ ft.

Sand _____

Gas _____

Oil _____

Total Depth 3325

PRODUCTION

1st 24 hrs. Nat. _____

1st 24 hrs. after shot _____

Gas _____ Cu. Ft.

Dry Hole _____

Abandoned _____

Date

DEC 19 1945

19

S. J. LEWIS Scout