


Section 1 Township 17 Range 15-W

Well No. #1 Hejny

Company E G Bradley

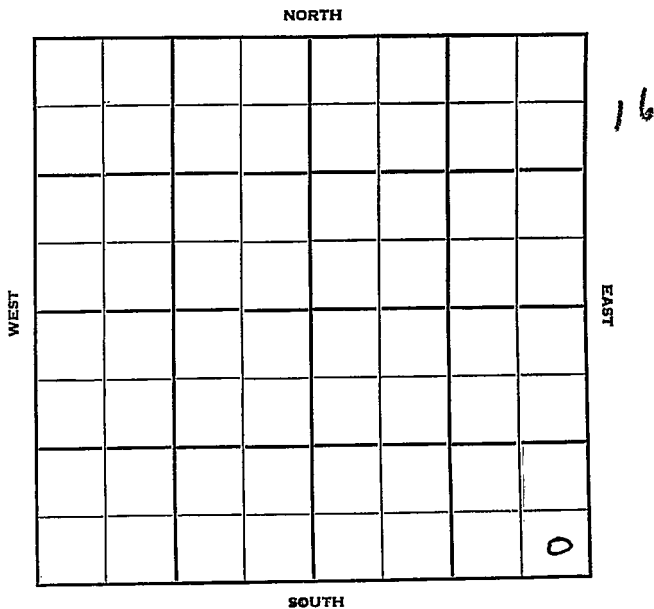

Barton

KANSAS

Sec. 1 Twp. 17 R. 15W

Well No. #1 Hejny Farm

E. G. Bradley Company

Barnett Drlg. - Contr. Contractor

Leoville Pool


 Ft. from N. Line

330' Ft. from S. Line

330' Ft. from E. Line

 Ft. from W. Line

SE SE SE

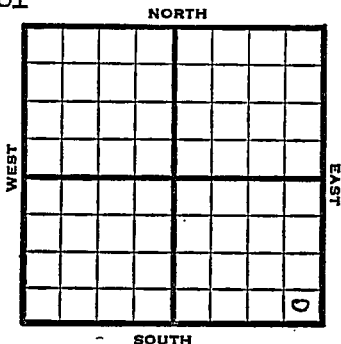

1950

Elev. 1976' REPORT

11/1

RUR

12/6

Spud 10-31-50

Oil Well TD 3471

8" @ 618' Anhy 915' 1" op. 2925

Heeb. 3156' Lans. 3223'

Cong. 3449' Arb. 3464'

TD 3465' 5" @ 3464

DD 3469' 1000 A


FU 500' oil DD 3471

FU 200' oil Comp. 50 bopd

COMPLETED

J. E. TYRA

County Barton State Kansas
 Sec. 1 (Blk.) 17 (Sur.) 15W Map No.
 Operator E. G. Bradley
 Well No. 1 Farm Hejny
 Elev. 1976 Location SE SE SE

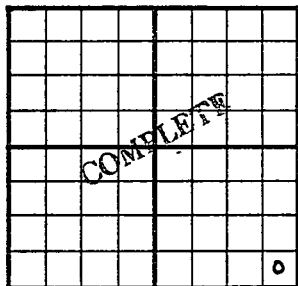

330 Ft. From S Line SE
330 Ft. From E Line Quarter
 Ist. Report
 Completion DEC 6 1950
 Remarks Leoville Pool
Barnett Drlg. - Contr.
 Spudding Date 10-31-50

Drlg. Data Oil well TD 3471
8" @ 618 Anhy 915 Top. 2925
Heeb. 3156 Lans. 3223 Cong. 3449
Arb. 3464 TD 3465 5" @ 3464
DD 3469 1000 A FU 500' oil DD 3471
FU 200' oil Comp. 50 bond