

Section 1 Township 17 Range 15-WWell No. #1 HejnyCompany John Lindas

NORTH

				0			

WEST

EAST

SOUTH

2

KANSAS
17

Barton
15-W

Sec. 1 Twp. 17 R. 15-W

Well No. #1 Hejny Farm

John Lindas Company

Contractor

Wildcat

330 Ft. from N. Line

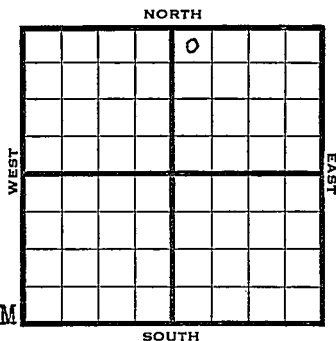
 Ft. from S. Line

 Ft. from E. Line

330 Ft. from W. Line

NW NW NE

Lion & Carter DHM



1950 Elev 1988 REPORT

7/12 8" @ 667
Anhy 987
Drlg 3060

7/19 8" @ 667
Anhy 987
Lans 3246
Cong 3494
TD 3552
D&A

Heeb 3184
Arb 3519

ABANDONED

Map No. _____ Sec. 1 Twp. 17 R. 15WWell No. 1 Hejny

_____ John Lindas _____ Company

_____ Contractor

NW N' NE

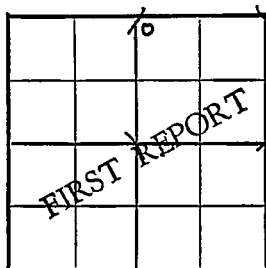
E 1. 1988

SECTION PLAT

330 Ft. from N. Line

_____ Ft. from S. Line

_____ Ft. from E. Line

330 Ft. from W. Line

Barton County

Lion & Carter DHM

Location _____

Rig up _____

Drilling and Remarks:

8" @ 667

Anhy 987

drlg. 3060

RECORD

Cased _____ in., _____ ft.

Sand _____

Gas _____

Oil _____

Total Depth _____

PRODUCTION

1st 24 hrs. Nat. _____

1st 24 hrs. after shot _____

Gas _____ Cu. Ft.

Dry Hole _____

Abandoned _____

Date

JUL 12 1950 19

J. E. TYRA

Scout

Kansas

Wildcat

Map No. _____ Sec. 1 Twp. 17 R. 15WWell No. 1 HejnyJohn Lindas

Company

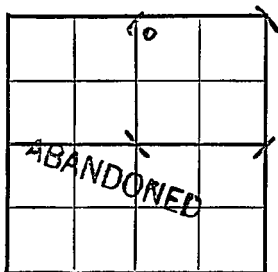
Contractor

NW NW NE

El. 1988
SECTION PLAT330 Ft. from N. Line

_____ Ft. from S. Line

_____ Ft. from E. Line

330 Ft. from W. LineBarton County

Location _____

Rig up _____

Drilling and Remarks:

8" @ 667

Anhy 987

Heeb. 3184

Lans. 3246

Arb. 3519

Cong. 3494

TD 3552

RECORD

Cased _____ in., _____ ft.

Sand _____

Gas _____

Oil _____

Total Depth 3552

PRODUCTION

1st 24 hrs. Nat. _____

1st 24 hrs. after shot _____

Gas _____ Cu. Ft.

Dry Hole _____

Abandoned _____

Date B & AJUL 10 1950

19

J. E. TYRA

Scout