


Section 8 Township 25 Range 5 E

Well No. # 257 Wilson

Company Cities Service

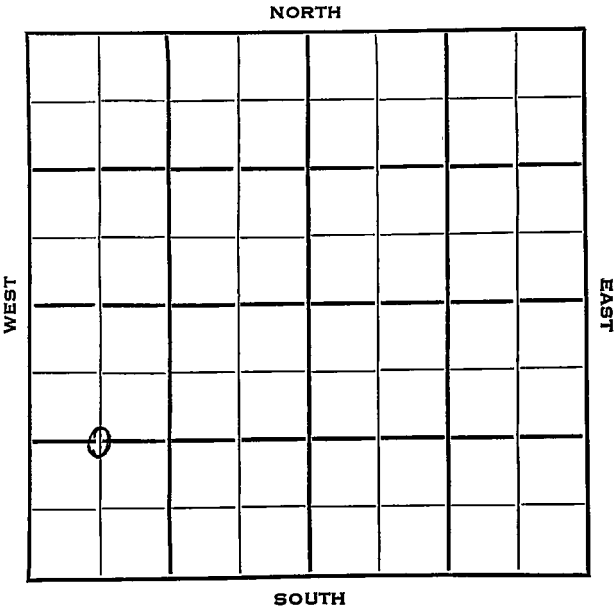

Butler KANSAS

SEC.	TWP.	R.
8	25	5E ✓

WELL NO.

257 Wilson

FARM

COMPANY

Cities Service

CONTRACTOR

Ft. from N. Line


1320

Ft. from S. Line

Ft. from E. Line

660

Ft. from W. Line

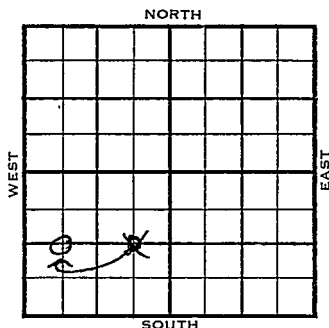

C W/2 SW

	ELEVATION	REPORT
1953	1377' RB	

12/30

Oil Well

TD 2619'

KC 1997', B KC 2159', Arb. 2392',

TD 2619'

7" @ 2563', 23/2512-21', SP 2486

21/2452-58, 16/2530-31, 17 bwph

CO to 2502 22/2512-21, 15/2452-58,

21/2417-22, 15 gwph

SP 2440

24/2403-13, 23/2394-2413'


21/2394-2403, 500A

Comp. 269 bopd

FIRST REPORT

COMPLETED

County **Butler** State **Kansas**
 Sec. **8** (Blk.) **25** (Sur. Rge.) **5E** Map No.
 Operator **Cities Service**
 Well No. **257** Farm **Wilson**
 Elev. **1377 RB** Location **C $\frac{1}{2}$ SW**

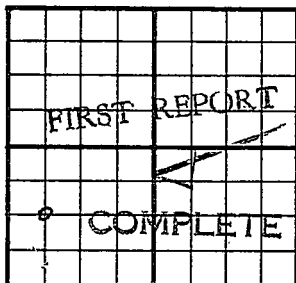

1320 Ft. From **S** Line **SW**
660 Ft. From **W** Line **Quarter**
 1st. Report **DEC 30 1953**
 Completion **DEC 30 1955**
 Remarks
 Spudding Date

Drlg. Data **Oil well** **TD 2619**
KC 1997 B KC 2159 Arb. 2392
TD 2619 7" @ 2563 23/ 2512-21
SP 2486 21/ 2452-58 16/ 2530-31
17 bwph CO to 2502 22/ 2512-21
15/ 2452-58 21/ 2417-22 15 gwph
SP 2440 24/ 2403-13 23/ 2394-2413
21/ 2394-2403 500 A Arb. 2394
Comp. 269 bopd

J. G. McGEHEE