


Section 8 Township 25 Range 5 E

Well No. # 258 Wilson

Company Cities Service

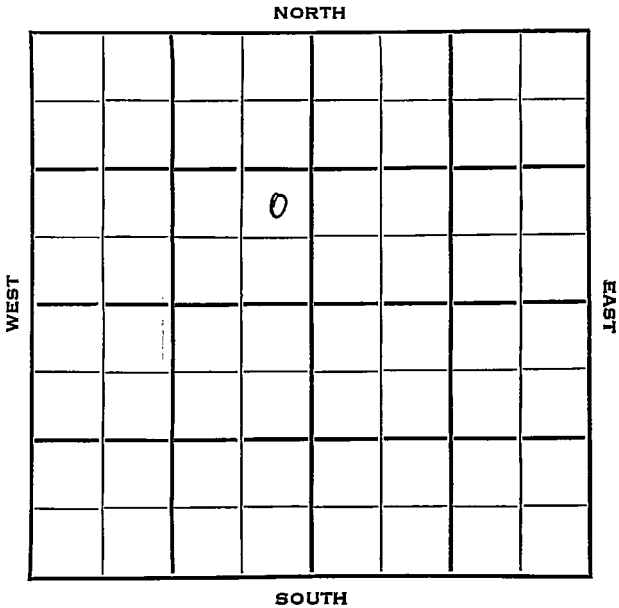

Butler

KANSAS

SEC.

TWP.

R.

8

25

5E

WELL NO.

#258 Wilson

FARM

COMPANY

Cities Service

CONTRACTOR

Eldorado Pool

NORTH

Ft. from N. Line


990

Ft. from S. Line

380

Ft. from E. Line

Ft. from W. Line

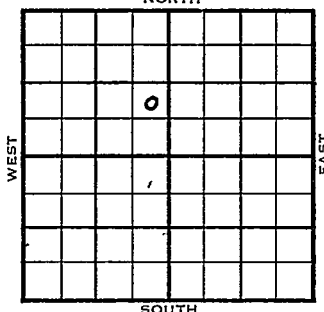

NE SE NW

1953

ELEVATION

REPORT

12/30

Oil Well

TD 2151'

8" @ 87'

Lans 1699', KC 1975',

TD 2151'

5" @ 2145'

51/ 1986-2008

1000 A

Comp 8 bopd 49 bw.

FIRST REPORT

COMPLETED

County **Butler** State **Kansas**
 Sec. **8** (Blk.) **25** (Sur.) **5E** Map No.
 Operator **Cities Service**
 Well No. **258** Farm **Wilson**
 Elev. Location **NE SE NW**

FIRST REPORT							
COMPLETE							

990 Ft. From **S** Line **NW**
 380 Ft. From **E** Line **Quarter**
 Ist. Report **DEC 30 1953**
 Completion **DEC 30 1953**
 Remarks
 Spudding Date

Drilg. Data **Oil well TD 2151 Eldorado Pool**
8" @ 87 Lens. 1699 KC 1975
TD 2151 5" @ 2145 51/ 1986-2008
1000 A Comp. 8 bopd 49 bw